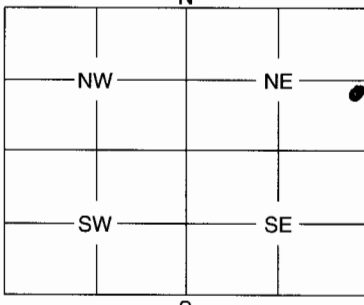


1	LOCATION OF WATER WELL: Johnson	Fraction NE NE SE NE	Section 28	Township T 12S	Number 25	Range 25	Number EW																											
County: Shell Gas Station 8120 Mission Rd. Prairie Village, Ks.																																		
2	WATER WELL OWNER: Shell Oil Products U.S. 308 Wilcox #101 Castle Rock, CO. 80104																																	
RR #, St. Address, Box #: City, State, ZIP Code :				Board of Agriculture, Division of Water Resources Application Number:																														
3	MARK WELL'S LOCATION WITH AN "X" IN SECTION BOX: 		4 DEPTH OF WELL 14' ft. WELL'S STATIC WATER LEVEL 5.5' ft. WELL WAS USED AS: <table border="0"><tr><td>1 Domestic</td><td>5 Public Water Supply</td><td>9 Dewatering</td></tr><tr><td>2 Irrigation</td><td>6 Oil Field Water Supply</td><td>10 Monitoring Well</td></tr><tr><td>3 Feedlot</td><td>7 Domestic (Lawn & Garden)</td><td>11 Injection Well</td></tr><tr><td>4 Industrial</td><td>8 Air Conditioning</td><td>12 Other recovery well</td></tr></table>					1 Domestic	5 Public Water Supply	9 Dewatering	2 Irrigation	6 Oil Field Water Supply	10 Monitoring Well	3 Feedlot	7 Domestic (Lawn & Garden)	11 Injection Well	4 Industrial	8 Air Conditioning	12 Other recovery well															
1 Domestic	5 Public Water Supply	9 Dewatering																																
2 Irrigation	6 Oil Field Water Supply	10 Monitoring Well																																
3 Feedlot	7 Domestic (Lawn & Garden)	11 Injection Well																																
4 Industrial	8 Air Conditioning	12 Other recovery well																																
Was a chemical / bacteriological sample submitted to Department? Yes No X If yes, mo/day/yr sample was submitted																																		
Water Well Disinfected: Yes No X																																		
5	TYPE OF BLANK CASING USED: <table border="0"><tr><td>1 Steel</td><td>3 RMP (SR)</td><td>5 Wrought</td><td>7 Fiberglass</td><td>9 Other (Specify below)</td></tr><tr><td>2 PVC</td><td>4 ABS</td><td>6 Asbestos-Cement</td><td>8 Concrete Tile</td><td></td></tr></table> Blank casing diameter 6" in. Was casing pulled? Yes No X If yes, how much Casing height above or below land surface 5' in.							1 Steel	3 RMP (SR)	5 Wrought	7 Fiberglass	9 Other (Specify below)	2 PVC	4 ABS	6 Asbestos-Cement	8 Concrete Tile																		
1 Steel	3 RMP (SR)	5 Wrought	7 Fiberglass	9 Other (Specify below)																														
2 PVC	4 ABS	6 Asbestos-Cement	8 Concrete Tile																															
6	GROUT PLUG MATERIAL: 1 Neat cement 2 Cement grout 3 Bentonite 4 Other Cement Grout Plug Intervals: From 14' ft. to 1' ft., From 1' ft. to 0' ft., From to ft. What is the nearest source of possible contamination: <table border="0"><tr><td>1 Septic tank</td><td>6 Seepage pit</td><td>11 Fuel storage</td><td>16 Other (specify below)</td></tr><tr><td>2 Sewer lines</td><td>7 Pit privy</td><td>12 Fertilizer storage</td><td></td></tr><tr><td>3 Watertight sewer lines</td><td>8 Sewage lagoon</td><td>13 Insecticide storage</td><td></td></tr><tr><td>4 Lateral lines</td><td>9 Feedyard</td><td>14 Abandoned water well</td><td></td></tr><tr><td>5 Cess pool</td><td>10 Livestock pens</td><td>15 Oil well/Gas well</td><td></td></tr></table> Direction from well? west How many feet? 30'							1 Septic tank	6 Seepage pit	11 Fuel storage	16 Other (specify below)	2 Sewer lines	7 Pit privy	12 Fertilizer storage		3 Watertight sewer lines	8 Sewage lagoon	13 Insecticide storage		4 Lateral lines	9 Feedyard	14 Abandoned water well		5 Cess pool	10 Livestock pens	15 Oil well/Gas well								
1 Septic tank	6 Seepage pit	11 Fuel storage	16 Other (specify below)																															
2 Sewer lines	7 Pit privy	12 Fertilizer storage																																
3 Watertight sewer lines	8 Sewage lagoon	13 Insecticide storage																																
4 Lateral lines	9 Feedyard	14 Abandoned water well																																
5 Cess pool	10 Livestock pens	15 Oil well/Gas well																																
<table border="1"><thead><tr><th>FROM</th><th>TO</th><th>PLUGGING MATERIALS</th></tr></thead><tbody><tr><td></td><td></td><td></td></tr><tr><td></td><td></td><td></td></tr><tr><td></td><td></td><td></td></tr><tr><td></td><td></td><td></td></tr><tr><td></td><td></td><td></td></tr><tr><td></td><td></td><td></td></tr><tr><td></td><td></td><td></td></tr><tr><td></td><td></td><td></td></tr></tbody></table>				FROM	TO	PLUGGING MATERIALS																									Flush mt manway was removed. 4" well casing was drilled and pulled out to TD. Bentonite from 14'-1' Cement from 1'-0' Soil from			
FROM	TO	PLUGGING MATERIALS																																
7	CONTRACTOR'S OF LANDOWNER'S CERTIFICATION: This water well was plugged under my jurisdiction and was completed on (mo/day/year) 12-1-05 732 and this record is true to the best of my knowledge and belief. Kansas Water Well Contractor's License No. 12-8-05 under the business name of JB Environmental Services This Water Well Record was completed on (mo/day/year) by (signature) James Bieker																																	
INSTRUCTIONS: Use typewriter or ball point pen. Please press firmly and print clearly. Please fill in blanks, underline or circle the correct answers. Send top three copies to Kansas Department of Health and Environment, Bureau of Water, Geology Section, 1000 SW Jackson St., Ste. 420, Topeka, Kansas 66612-1367. Telephone: 785/296-5522. Send one to Water Well Owner and retain one for your records.																																		