


1 LOCATION OF WATER WELL: County: Johnson Fraction SW 1/4 NW 1/4 NE 1/4 Section Number 5 Township Number T 12 S Range Number R 25 E

Distance and direction from nearest town or city street address of well if located within city? 4801 Lamar Avenue, Mission, Kansas

2 WATER WELL OWNER: U-Do Store #6 c/o Ernest Rohr RR#, St. Address, Box #: 4801 Lamar Avenue City, State, ZIP Code: Missions, Kansas Board of Agriculture, Division of Water Resources Application Number:

3 LOCATE WELL'S LOCATION WITH AN "X" IN SECTION BOX:

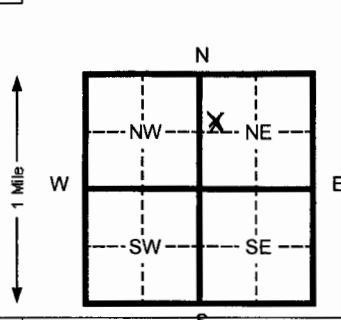

4 DEPTH OF COMPLETED WELL 15 ft. ELEVATION: Depth(s) Groundwater Encountered 1 ft. 2 ft. 3 ft. WELL'S STATIC WATER LEVEL NA ft. below land surface measured on mo/day/yr Pump test data: Well water was ... Ft. after ... hours pumping ... Gpm Est. Yield ... Gpm Well water was ... Ft. after ... Hours pumping ... Gpm Bore Hole Diameter 8.0 in. to 15 in. and ... in. to ... Ft. WELL WATER TO BE USED AS: 5 Public water supply 8 Air conditioning 11 Injection well 1 Domestic 3 Feed lot 6 Oil field water supply 9 Dewatering 12 Other (Specify below) 2 Irrigation 4 Industrial 7 Lawn and garden (domestic) 10 Monitoring well MW-4 Was a chemical/bacteriological sample submitted to Department? Yes No X If yes, mo/day/yr sample was Submitted Water Well Disinfected? Yes No X

5 TYPE OF BLANK CASING USED: 1 Steel 3 RMP (SR) 5 Wrought Iron 8 Concrete tile CASING JOINTS: Glued Clamped 2 PVC 4 ABS 6 Asbestos-Cement 9 Other (specify below) Welded 7 Fiberglass Threaded X

Blank casing diameter 2 in. to 5 in. Dia. SCH 40 Lbs./ft. Wall thickness or gauge No.

TYPE OF SCREEN OR PERFORATION MATERIAL: 1 Steel 3 Stainless steel 5 Fiberglass 8 RMP (SR) 11 Other (specify) 2 Brass 4 Galvanized steel 6 Concrete tile 9 ABS 12 None used (open hole) 7 PVC 10 Asbestos-cement

SCREEN OR PERFORATION OPENINGS ARE: 1 Continuous slot 3 Mill slot 5 Gauzed wrapped 8 Saw cut 11 None (open hole) 2 Louvered shutter 4 Key punched 6 Wire wrapped 9 Drilled holes 7 Torch cut 10 Other (specify)

SCREEN-PERFORATED INTERVALS: From 5 ft. to 15 ft. SAND PACK INTERVALS: From 3 ft. to 15 ft.

6 GROUT MATERIAL: 1 Neat cement 2 Cement grout 3 Bentonite 4 Other Grout Intervals From 0 ft. to 1 ft. From 1 ft. to 3 ft.

What is the nearest source of possible contamination: 1 Septic tank 4 Lateral lines 7 Pit privy 10 Livestock pens 14 Abandoned water well 2 Sewer lines 5 Cess pool 8 Sewage lagoon 11 Fuel storage 15 Oil well/ Gas well 3 Watertight sewer lines 6 Seepage pit 9 Feedyard 12 Fertilizer storage 16 Other (specify below) Contaminated Site Direction from well? How many feet?

Table with columns: FROM, TO, CODE, LITHOLOGIC LOG, FROM, TO, PLUGGING INTERVALS. Rows include: 0 to .5 Concrete; .5 to 6 Brown, silt, high plastic; 6 to 13 Clay (CL); 13 to 15 Shale, light gray; 15 to TD End of Borehole.

7 CONTRACTOR'S OR LANDOWNER'S CERTIFICATION: This water well was (x) constructed, (2) reconstructed, or (3) plugged under my jurisdiction and was Completed on (mo/day/yr) 04/24/06 And this record is true to the best of my knowledge and belief. Kansas Water Well Contractor's License No. 585 This Water Well Record was completed on (mo/day/yr) 05/04/06 under the business name of Associated Environmental, Inc. By (signature) Bradley J. Johnson

INSTRUCTIONS: Please fill in blanks and circle the correct answers. Send three copies to Kansas Department of Health and Environment, Bureau of Water, P.O. Box 66620-0001. Telephone: 913-296-5545. Send one to WATER WELL OWNER and retain one for your records.

OFFICE USE ONLY

T

R

SEC