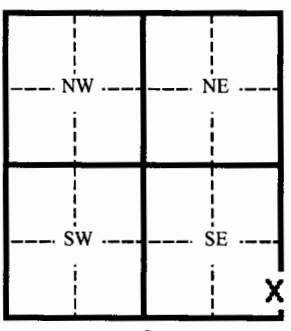
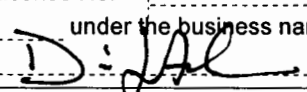


1 LOCATION OF WATER WELL:		Fraction	Section Number	Township Number	Range Number																																
County: Johnson		SE 1/4 SE 1/4 SE 1/4	33	12S	25E																																
Distance and direction from nearest town or city street address of well if located within city? 9440 Mission Road, Prairie Village, N38° 57.431' W94°37.843'																																					
2 WATER WELL OWNER: Phillips 66 #18676		Board of Agriculture, Division of Water Resources																																			
RR#, St. Address, Box # 9440 Mission Road		Application Number:																																			
City, State, ZIP Code : Prairie Village, KS 66206																																					
3 MARK WELL'S LOCATION WITH AN "X" IN SECTION BOX:		4 DEPTH OF WELL 15 ft.																																			
		WELL'S STATIC WATER LEVEL 10.88 ft.																																			
		WELL WAS USED AS:																																			
		1 Domestic 2 Irrigation 3 Feedlot 4 Industrial 5 Public Water Supply 6 Oil Field Water Supply 7 Lawn and Garden (domestic) 8 Air Conditioning 9 Dewatering 10 Monitoring Well 11 Injection Well 12 Other																																			
		Was a chemical/bacteriological sample submitted to Department? Yes No X																																			
		If yes, mo/day/yr sample was submitted																																			
		Water Well Disinfected: Yes No X																																			
5 TYPE OF BLANK CASING USED:																																					
1 Steel 2 PVC 3 RMP (SR) 4 ABC 5 Wrought 6 Asbestos-Cement 7 Fiberglass 8 Concrete Tile 9 Other (specify below)																																					
Blank casing diameter 2 in. Was casing pulled? Yes X No If yes, how much Removed casing to 3 ft. bgs																																					
Casing height above or below land surface -6 in.																																					
6 GROUT PLUG MATERIAL: 1 Neat cement 2 Cement grout 3 Bentonite 4 Other																																					
Grout Plug Intervals From 0.5 ft. to 15 ft. From ft. to ft. From ft. to ft.																																					
What is the nearest source of possible contamination:																																					
1 Septic tank 2 Sewer lines 3 Watertight sewer lines 4 Lateral lines 5 Cess Pool 6 Seepage pit 7 Pit privy 8 Sewage lagoon 9 Feedyard 10 Livestock pens 11 Fuel storage 12 Fertilizer storage 13 Insecticide storage 14 Abandoned water well 15 Oil well/ Gas well 16 Other (specify below)																																					
Direction from well? unknown How many feet? unknown																																					
<table border="1"><thead><tr><th>FROM</th><th>TO</th><th>CODE</th><th>PLUGGING MATERIALS</th></tr></thead><tbody><tr><td>0</td><td>0.5</td><td>--</td><td>Concrete</td></tr><tr><td>0.5</td><td>15</td><td>--</td><td>Bentonite chips</td></tr><tr><td></td><td></td><td></td><td></td></tr><tr><td></td><td></td><td></td><td></td></tr><tr><td></td><td></td><td></td><td></td></tr><tr><td></td><td></td><td></td><td></td></tr><tr><td></td><td></td><td></td><td></td></tr></tbody></table>						FROM	TO	CODE	PLUGGING MATERIALS	0	0.5	--	Concrete	0.5	15	--	Bentonite chips																				
FROM	TO	CODE	PLUGGING MATERIALS																																		
0	0.5	--	Concrete																																		
0.5	15	--	Bentonite chips																																		
7 CONTRACTOR'S OR LANDOWNER'S CERTIFICATION: This water well was plugged under my jurisdiction and was completed on (mo/day/yr) 5/2/07 and this record is true to the best of my knowledge and belief. Kansas Water Well Contractor's License No. 616 This Water Well Record was completed on (mo/day/yr) 5/17/07 under the business name of Thiele Geotech, Inc. by (signature) 																																					
INSTRUCTIONS: Please fill in blanks and circle the correct answers. Send three copies to Kansas Department of Health and Environment, Bureau of Water, 1000 S W Jackson St., Ste. 420, Topeka, Kansas 66620-0001. Telephone: 785-296-3565. Send one to Water Well Owner and retain one for your records.																																					