

CORRECTION(S) TO WATER WELL RECORD (WWC-5)
(to rectify lacking or incorrect information)

Location listed as:

Section-Township-Range: 9-12 S-22 E

Fraction ($\frac{1}{4}$ $\frac{1}{4}$ $\frac{1}{4}$): SE SW NW

County: Johnson

Location changed to:

9-12 S-25 E

SE SW NW

Other changes: Initial statements: Wyandotte County

Changed to: Johnson County

Comments:

verification method: well address, city street map, legal description, position on plat map, and mapping tool on KGS website.

initials: BR date: 3/17/2008

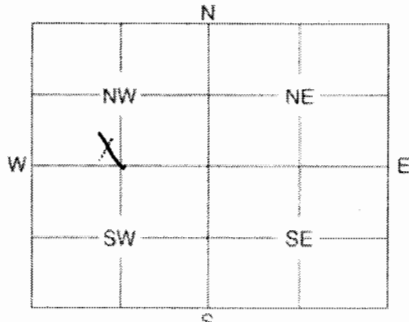
submitted by: Kansas Geological Survey, Data Resources Library, 1930 Constant Ave., Lawrence, KS 66047-3726
to: Kansas Dept of Health & Environment, Bureau of Water, 1000 SW Jackson, Suite 420, Topeka, KS 66612-1367.

1	LOCATION OF WATER WELL: Wyandotte	Fraction SE $\frac{1}{4}$ SW $\frac{1}{4}$ NW $\frac{1}{4}$	Section Number 9	Township Number 12S	Range Number 22E
County: Wyandotte					

Distance and direction from nearest town or city street address of well if located within city?

5200 Johnson Drive, Mission Kansas

2	WATER WELL OWNER: Goodyear (SM Partners Property) KDHE T&M
RR #, St. Address, Box #: 1000 SW Jackson #410	
City, State, ZIP Code: Topeka, Ks 6612-1367	
Board of Agriculture, Division of Water Resources Application Number:	

3	MARK WELL'S LOCATION WITH AN "X" IN SECTION BOX:	4	DEPTH OF WELL 12.70 ft.
		WELL'S STATIC WATER LEVEL 5.15 ft.	
		WELL WAS USED AS:	
		1 Domestic 5 Public Water Supply 9 Dewatering 2 Irrigation 6 Oil Field Water Supply 10 Monitoring Well 3 Feedlot 7 Domestic (Lawn & Garden) 11 Injection Well 4 Industrial 8 Air Conditioning 12 Other	
Was a chemical / bacteriological sample submitted to Department? Yes No X			
If yes, mo/day/yr sample was submitted			
Water Well Disinfected: Yes No X			

5	TYPE OF BLANK CASING USED:
1 Steel 3 RMP (SR) 5 Wrought 7 Fiberglass 9 Other (Specify below) 2 PVC 4 ABS 6 Asbestos-Cement 8 Concrete Tile	
Blank casing diameter in. Was casing pulled? Yes X No If yes, how much 103	
Casing height above or below land surface in.	

6	GROUT PLUG MATERIAL:
1 Neat cement 2 Cement grout 3 Bentonite 4 Other surface silts/clays	
Grout Plug Intervals: From 3 12.70 ft. to 1 ft. From 4 1 ft. to 0 ft. From to	
What is the nearest source of possible contamination:	
1 Septic tank 6 Seepage pit 11 Fuel storage 2 Sewer lines 7 Pit privy 12 Fertilizer storage 3 Watertight sewer lines 8 Sewage lagoon 13 Insecticide storage 4 Lateral lines 9 Feedyard 14 Abandoned water well 5 Cess pool 10 Livestock pens 15 Oil well-Gas well	
Direction from well? How many feet?	

FROM	TO	PLUGGING MATERIALS
12.70	1	Bentonite
1	0	surface silts/clays

7	CONTRACTOR'S OF LANDOWNER'S CERTIFICATION: This water well was plugged under my jurisdiction and was completed on (mo/day/year) 01/30/08 and this record is true to the best of my knowledge and belief. Kansas Water Well Contractor's License No. 585 This Water Well Record was completed on (mo/day/year) 02/19/08 under the business name of Associated Environmental, Inc. by (signature) B. Johnson
---	---

INSTRUCTIONS: Use typewriter or ball point pen. Please press firmly and print clearly. Please fill in blanks, underline or circle the correct answers. Send top three copies to Kansas Department of Health and Environment, Bureau of Water, Geology Section, 1000 SW Jackson St., Ste. 420, Topeka, Kansas 66612-1367. Telephone: 785/296-5522. Send one to Water Well Owner and retain one for your records.