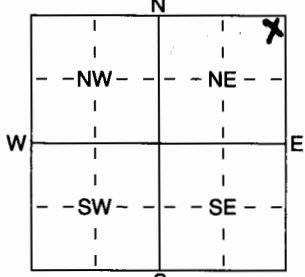


1 LOCATION OF WATER WELL: County: Johnson	Fraction NE 1/4 NE 1/4 NE 1/4	Section Number 6	Township Number T 12 S	Range Number R 25 EW
--	----------------------------------	---------------------	---------------------------	-------------------------

Distance and direction from nearest town or city street address of well if located within city?
 Overland Park 3456 Merriam Lane, Overland Park KS

2 WATER WELL OWNER: RR#, St. Address, Box # : 5590 Torres Drive City, State, ZIP Code : Denver, CO 80239	MR Properties Co. LLC Havana St	Board of Agriculture, Division of Water Resources Application Number:
--	------------------------------------	--

3 LOCATE WELL'S LOCATION WITH AN "X" IN SECTION BOX: 	4 DEPTH OF COMPLETED WELL 19 ft. ELEVATION: Depth(s) Groundwater Encountered 1.5' 7.5' ft. 2 ft. 3 ft. WELL'S STATIC WATER LEVEL 7.5' ft. below land surface measured on mo/day/yr 2/2/07 Pump test data: Well water was ft. after hours pumping gpm Est. Yield gpm: Well water was ft. after hours pumping gpm WELL WATER TO BE USED AS: 5 Public water supply 8 Air conditioning 11 Injection well 1 Domestic 3 Feedlot 6 Oil field water supply 9 Dewatering 12 Other (Specify below) 2 Irrigation 4 Industrial 7 Domestic (lawn & garden) 10 Monitoring well
--	--

Was a chemical/bacteriological sample submitted to Department? Yes (No); If yes, mo/day/yrs sample was submitted
 Water Well Disinfected? Yes No

5 TYPE OF BLANK CASING USED: 1 Steel 3 RMP (SR) 2 PVC 4 ABS	5 Wrought iron 6 Asbestos-Cement 7 Fiberglass	8 Concrete tile 9 Other (specify below)	CASING JOINTS: Glued Clamped Welded Threaded
---	---	--	--

Blank casing diameter 2 in. to 4 ft. Dia in. to ft. Dia in. to ft.
 Casing height above land surface 0-6 in., weight lbs./ft. Wall thickness or gauge No. SCH 40
 TYPE OF SCREEN OR PERFORATION MATERIAL:
 1 Steel 3 Stainless Steel 5 Fiberglass 8 RMP (SR)
 2 Brass 4 Galvanized Steel 6 Concrete tile 9 ABS 10 Asbestos-Cement 11 Other (Specify)
 12 None used (open hole)

SCREEN OR PERFORATION OPENINGS ARE:
 1 Continuous slot 2 Louvered shutter 3 Mill slot 4 Key punched
 5 Gauzed wrapped 6 Wire wrapped 7 Torch cut 8 Saw cut 9 Drilled holes 11 None (open hole)
 10 Other (specify) ft.

SCREEN-PERFORATED INTERVALS: From 4 ft. to 19 ft., From ft. to ft.
 GRAVEL PACK INTERVALS: From ft. to ft., From ft. to ft.

6 GROUT MATERIAL: 1 Neat cement 2 Cement grout 3 Bentonite 4 Other
--

Grout Intervals: From 1 ft. to 3 ft., From ft. to ft., From ft. to ft.

What is the nearest source of possible contamination:
 1 Septic tank 4 Lateral lines 7 Pit privy 10 Livestock pens 14 Abandoned water well
 2 Sewer lines 5 Cess pool 8 Sewage lagoon 11 Fuel storage 15 Oil well/Gas well
 3 Watertight sewer lines 6 Seepage pit 9 Feedyard 12 Fertilizer storage 16 Other (specify below)
 13 Insecticide storage
 Direction from well? How many feet?

FROM	TO	LITHOLOGIC LOG	FROM	TO	PLUGGING INTERVALS
0	19	Black clay loam			

7 CONTRACTOR'S OR LANDOWNER'S CERTIFICATION: This water well was <u>(1)</u> constructed, (2) reconstructed, or (3) plugged under my jurisdiction and was completed on (mo/day/year) 2/7/07 and this record is true to the best of my knowledge and belief. Kansas Water Well Contractor's Licence No 799 This Water Well Record was completed on (mo/day/yr) 2/18/08 under the business name of ATL ASSOCIATES by signature [Signature]
