

WATER WELL PLUGGING RECORD Form WWC-5P

KSA 82a-1212

ID NO.

MW-3

1 LOCATION OF WATER WELL:

County: Johnson

Fraction

NW 1/4 SW 1/4 SW 1/4

Section Number

32

Township Number

12 S

Range Number

25 E

Distance and direction from nearest town or city street address of well if located within city?

9301 Metcalf, Overland Park, KS

2 WATER WELL OWNER:

RR#, St. Address, Box #:

City, State ZIP Code:

BP Products North America28100 Torch Pkwy MC25Warrenville, IL 60555

Global Positioning Systems (decimal degrees, min. of 4 digits)

Latitude: _____

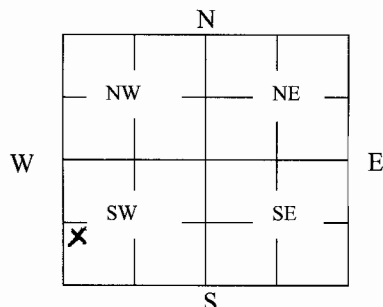
Longitude: _____

Elevation: _____

Datum: _____

Data Collection Method: _____

3 MARK WELL'S LOCATION WITH AN "X" IN SECTION BOX:

4 DEPTH OF WELL 14 ft.WELL'S STATIC WATER LEVEL 4.69 ft.

WELL WAS USED AS:

1 Domestic

2 Irrigation

3 Feedlot

4 Industrial

5 Public Water Supply

6 Oil Field Water Supply

7 Domestic (Lawn & Garden)

8 Air Conditioning

9 Dewatering

☒ 10 Monitoring

11 Injection Well

12 Other _____

Was a chemical/bacteriological sample submitted to Department? Yes _____ No ☒

5 TYPE OF BLANK CASING USED:

1 Steel

3 RMP (SR)

5 Wrought

7 Fiberglass

9 Other (Specify below) _____

☒ 2 PVC

4 ABS

6 Asbestos-Cement

8 Concrete Tile

Blank casing diameter 2 in. Was casing pulled? Yes _____ No ☒ If yes, how much _____Casing height above or below land surface 48 in.

6 GROUT PLUG MATERIAL:

1 Neat cement

2 Cement grout

☒ 3 Bentonite

4 Other _____

Grout Plug Intervals: From 1 ft. to 14 ft., From _____ ft. to _____ ft., From _____ to _____ ft.

What is the nearest source of possible contamination:

1 Septic tank

6 Seepage pit

☒ 11 Fuel Storage

16 Other (specify below) _____

2 Sewer lines

7 Pit privy

12 Fertilizer storage

3 Watertight sewer lines

8 Sewage lagoon

13 Insecticide storage

4 Lateral lines

9 Feedyard

14 Abandoned water well

Direction from well? W

5 Cess pool

10 Livestock pens

15 Oil well/Gas well

How many feet? 10'

FROM	TO	PLUGGING MATERIALS	FROM	TO	PLUGGING MATERIALS
<u>0</u>	<u>1</u>	<u>concrete</u>			
<u>1</u>	<u>14</u>	<u>bentonite</u>			

7 CONTRACTOR'S OR LANDOWNER'S CERTIFICATION:

This water well was plugged under my jurisdiction and was completed on (mo/day/year) 08/21/09 and this record is true to the best of my knowledge and belief. Kansas Water Well Contractor's License No. NA. This Water Well Record was completed on (mo/day/year) 09/14/09 under the business name of Terranext, LLC by (signature) Wm. P. Watson

INSTRUCTIONS: Use typewriter or ballpoint pen. Please press firmly and print clearly. Please fill in blanks, underline or circle the correct answers. Send top three copies to Kansas Department of Health and Environment, Bureau of Water, Geology Section, 1000 SW Jackson St., Ste. 420, Topeka, Kansas 66612-1367. Telephone: 785/296-5522. Send one to Water Well Owner and retain one for your records. Visit us at <http://www.kdheks.gov/geo/waterwells>.