


Division of Water Resources App. No.

CORRECTED

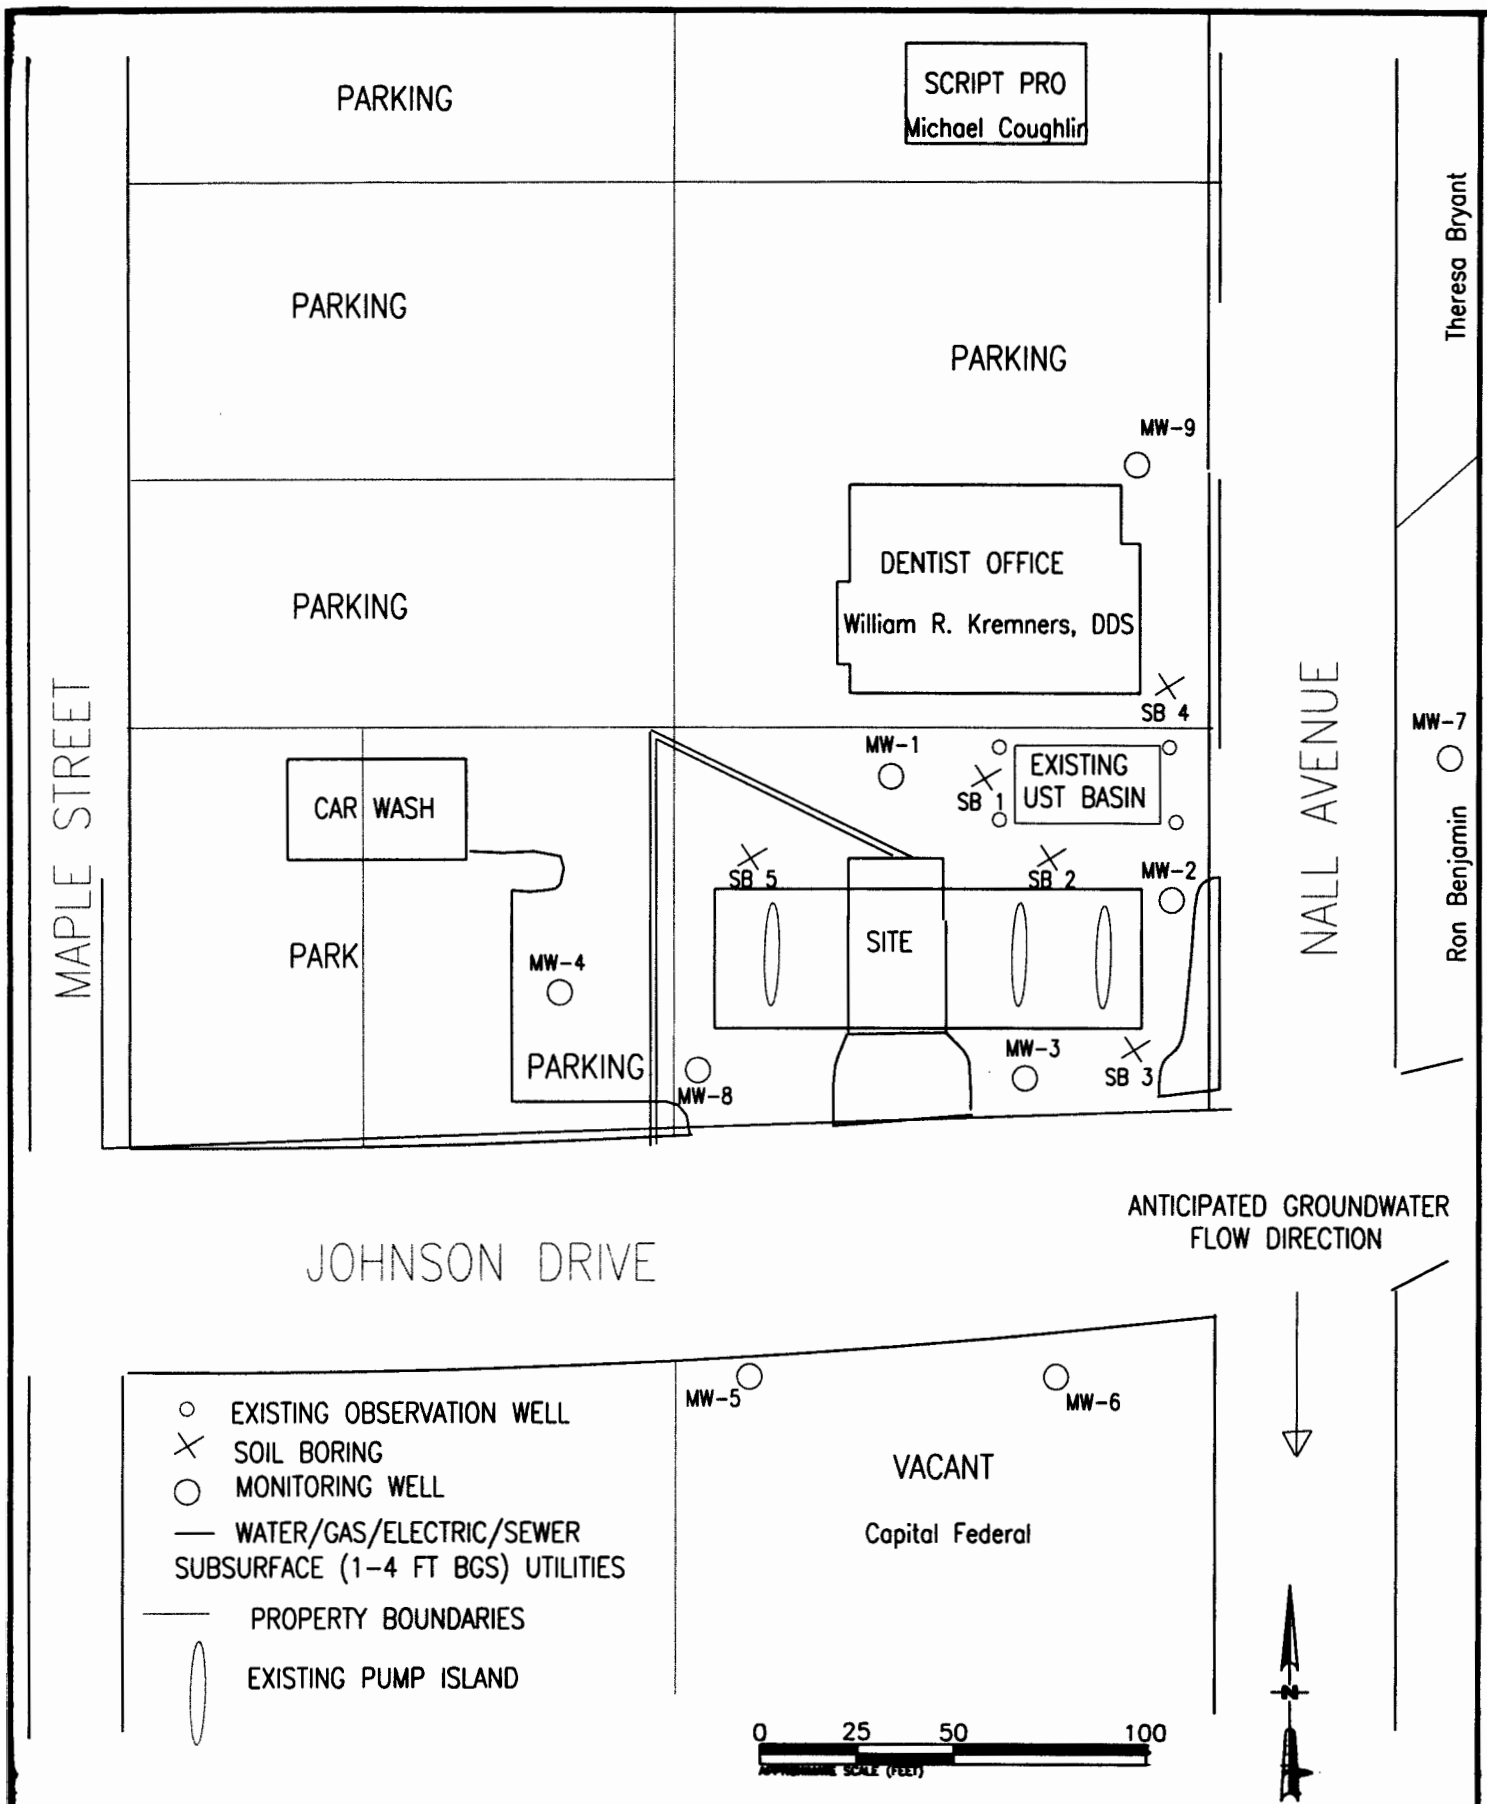

PROJ. # 17102596

PAGE #

SCALE: AS SHOWN

DRAWN BY: RB

FILE NO.

DESIGNED BY:

DATE: 9-30-09

APPROVED BY:

BE K/Terranext

FIGURE 2
SITE PLAN
JOHNSON DRIVE BP
5500 JOHNSON DRIVE
MISSION, KS
U4-046-14020