

WATER WELL RECORD

Form WWC-5

Division of Water Resources App. No.

1 LOCATION OF WATER WELL: County: Johnson Street/Rural Address of Well Location; if unknown, distance & direction from nearest town or intersection: If at owner's address, check here ☐ 5500 Johnson Drive Mission, Kansas	Fraction SE 1/4 SE 1/4 SE 1/4 NE 1/4	Section Number 8	Township No. T 12 S	Range Number R 25 E
---	---	---------------------	------------------------	------------------------

Global Positioning System (GPS) information:
 Latitude: N39.1' 21.1" (in decimal degrees)
 Longitude: W94.38' 57.7" (in decimal degrees)
 Elevation: _____
 Datum: ☐ WGS 84, ☐ NAD 83, ☐ NAD 27
 Collection Method:
☒ GPS unit (Make/Model: Garmin Nuvi 760)
☐ Digital Map/Photo, ☐ Topographic Map, ☐ Land Survey
 Est. Accuracy: ☐ <3 m, ☐ 3-5 m, ☐ 5-15 m, ☐ >15 m

3 LOCATE WELL WITH AN "X" IN SECTION BOX: N <table border="1" style="margin: auto;"> <tr> <td style="padding: 5px;">NW</td> <td style="padding: 5px;">NE</td> </tr> <tr> <td style="padding: 5px;">SW</td> <td style="padding: 5px;">SE</td> </tr> </table> S -----1 mile-----	NW	NE	SW	SE	4 DEPTH OF COMPLETED WELL 13 ft. Depth(s) Groundwater Encountered (1) ~10 ft. (2) _____ ft. (3) _____ ft. WELL'S STATIC WATER LEVEL 5.60 ft. below land surface measured on mo/day/yr. 12/05/09 Pump test data: Well water was _____ ft. after _____ hours pumping _____ gpm EST. YIELD _____ gpm. Well water was _____ ft. after _____ hours pumping _____ gpm Bore Hole Diameter 8.25 in. to 13 in. and _____ in. to _____ ft. WELL WATER TO BE USED AS: ☐ Public water supply ☐ Geothermal ☐ Injection well ☐ Domestic ☐ Feedlot ☐ Oil field water supply ☐ Dewatering ☐ Other (Specify below) ☐ Irrigation ☐ Industrial ☐ Domestic-lawn & garden ☒ Monitoring well MW-2 Was a chemical/bacteriological sample submitted to Department? ☐ Yes ☒ No If yes, mo/day/yr sample was submitted _____ Water well disinfected? ☐ Yes ☒ No
NW	NE				
SW	SE				


5 TYPE OF CASING USED: ☐ Steel ☒ PVC ☐ Other _____
CASING JOINTS: ☐ Glued ☐ Clamped ☐ Welded ☒ Threaded
 Casing diameter 2 in. to 13 ft., Diameter _____ in. to _____ ft., Diameter _____ in. to _____ ft.
 Casing height above land surface 0 in., Weight _____ lbs./ft., Wall thickness or gauge No. Sch. 40
TYPE OF SCREEN OR PERFORATION MATERIAL:
☐ Steel ☐ Stainless Steel ☒ PVC ☐ Other (Specify) _____
☐ Brass ☐ Galvanized Steel ☐ None used (open hole)
SCREEN OR PERFORATION OPENINGS ARE:
☐ Continuous slot ☒ Mill slot ☐ Gauze wrapped ☐ Torch cut ☐ Drilled holes ☐ None (open hole)
☐ Louvered shutter ☐ Key punched ☐ Wire wrapped ☐ Saw cut ☐ Other (specify) _____
SCREEN-PERFORATED INTERVALS: From 4 ft. to 13 ft., From _____ ft. to _____ ft.
 From _____ ft. to _____ ft., From _____ ft. to _____ ft.
GRAVEL PACK INTERVALS: From 3 ft. to 13 ft., From _____ ft. to _____ ft.
 From _____ ft. to _____ ft., From _____ ft. to _____ ft.

6 GROUT MATERIAL: ☐ Neat cement ☐ Cement grout ☒ Bentonite ☐ Other Concrete from 0 to 1 ft.
 Grout Intervals: From 1 ft. to 3 ft., From _____ ft. to _____ ft., From _____ ft. to _____ ft.
 What is the nearest source of possible contamination:
☐ Septic tank ☐ Lateral lines ☐ Pit privy ☐ Livestock pens ☐ Insecticide storage ☐ Other (specify below)
☐ Sewer lines ☐ Cesspool ☐ Sewage lagoon ☒ Fuel storage ☐ Abandoned water well
☐ Watertight sewer lines ☐ Seepage pit ☐ Feedyard ☐ Fertilizer storage ☐ Oil well/gas well
 Direction from well _____ Distance from well _____

FROM	TO	LITHOLOGIC LOG	FROM	TO	LITHO. LOG (cont.) or PLUGGING INTERVALS
0	1	Asphalt			
1	6	Black CLAY			
6	9.5	SAND			
9.5	13	Grey and Brown silty CLAY			
12	13	Grey SHALE			

CORRECTED

7 CONTRACTOR'S OR LANDOWNER'S CERTIFICATION: This water well was ☒ constructed, ☐ reconstructed, or ☐ plugged under my jurisdiction and was completed on (mo/day/year) 12-3-09 and this record is true to the best of my knowledge and belief.
 Kansas Water Well Contractor's License No. 759 This Water Well Record was completed on (mo/day/year) 12-13-09
 under the business name of RAZEK Environmental LLC by (signature) *[Signature]*
INSTRUCTIONS: Use typewriter or ball point pen. PLEASE PRESS FIRMLY and PRINT clearly. Please fill in blanks and check the correct answers. Send three copies (white, blue, pink) to Kansas Department of Health and Environment, Bureau of Water, Geology Section, 1000 SW Jackson St., Suite 420, Topeka, Kansas 66612-1367. Telephone 785-296-5522. Send one copy to WATER WELL OWNER and retain one for your records. Include fee of \$5.00 for each constructed well. Visit us at <http://www.kdheks.gov/waterwell/index.html>.

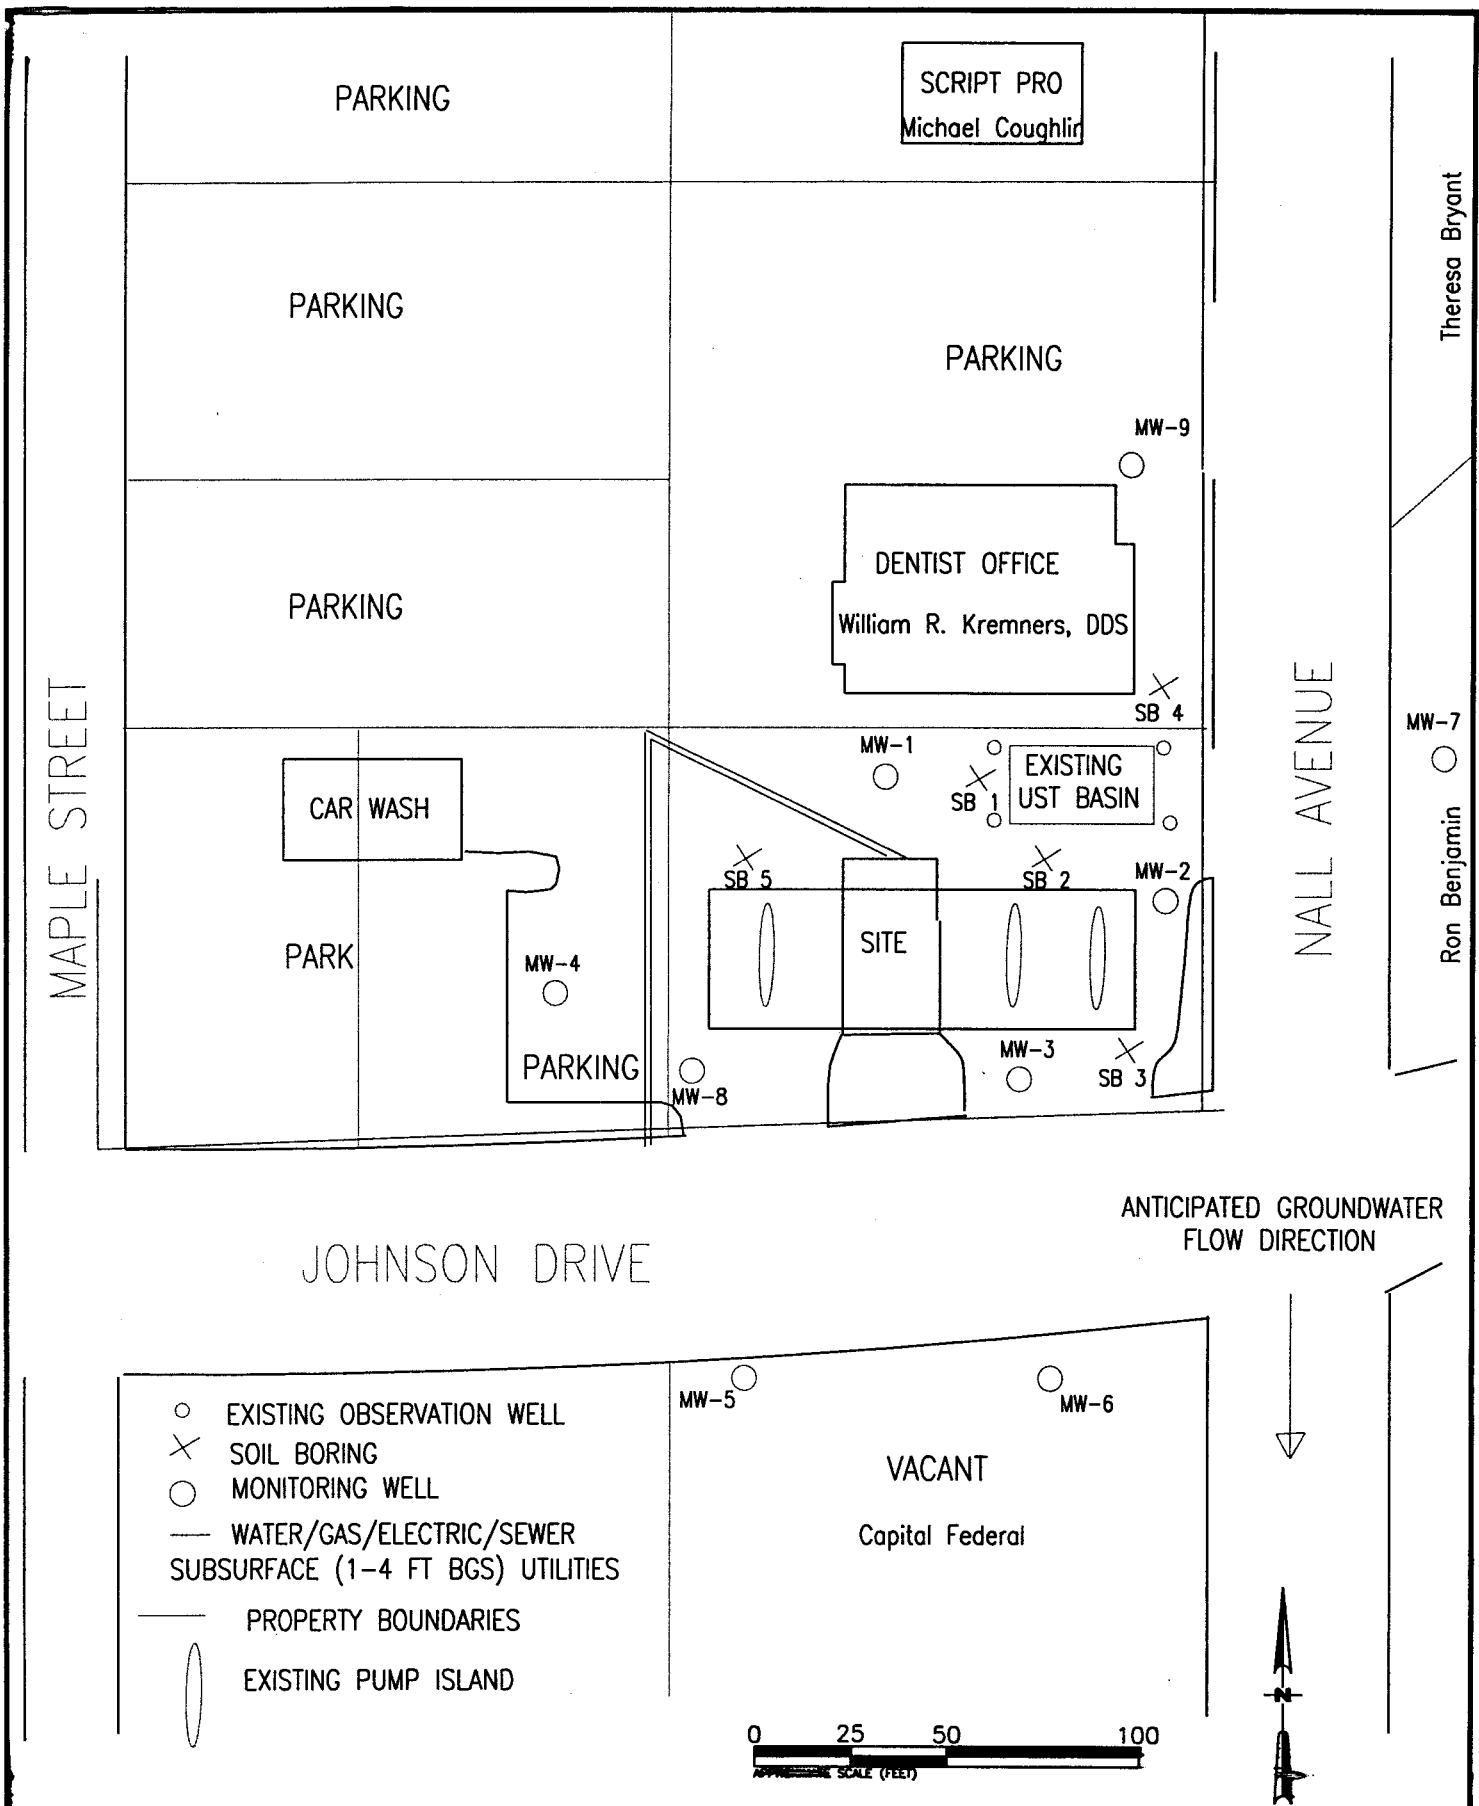

PROJ. # 17102596	PAGE #	BE K/TerraNext	FIGURE 2 SITE PLAN JOHNSON DRIVE BP 5500 JOHNSON DRIVE MISSION, KS U4-046-14020
SCALE: AS SHOWN	DRAWN BY: RB		
FILE NO.	DESIGNED BY:		
DATE: 9-30-09	APPROVED BY:		