


WATER WELL RECORD

Form WWC-5

Division of Water Resources App. No.

1 LOCATION OF WATER WELL: County: Johnson		Fraction <u>SE 1/4 SE 1/4 SE 1/4 NE 1/4</u>	Section Number <u>8</u>	Township No. <u>T 12 S</u>	Range Number <u>R 25 E</u> ☐ W	
Street/Rural Address of Well Location; if unknown, distance & direction from nearest town or intersection: If at owner's address, check here ☐ . 5500 Johnson Drive Mission, Kansas			Global Positioning System (GPS) information: Latitude: <u>N39.1'21.1"</u> (in decimal degrees) Longitude: <u>W94.38'57.7"</u> (in decimal degrees) Elevation: _____ Datum: ☐ WGS 84, ☐ NAD 83, ☐ NAD 27 Collection Method: ☒ GPS unit (Make/Model: <u>Garmin Nuvi 760</u>) ☐ Digital Map/Photo, ☐ Topographic Map, ☐ Land Survey Est. Accuracy: ☐ <3 m, ☐ 3-5 m, ☐ 5-15 m, ☐ >15 m	
2 WATER WELL OWNER: <u>BP Products North America</u> RR#, Street Address, Box #: <u>28100 Torch Pkwy</u> City, State, ZIP Code: <u>Warrenville, IL 60555</u>	
3 LOCATE WELL WITH AN "X" IN SECTION BOX: 		4 DEPTH OF COMPLETED WELL <u>12</u> ft. Depth(s) Groundwater Encountered (1) <u>10</u> ft. (2) _____ ft. (3) _____ ft. WELL'S STATIC WATER LEVEL <u>5.93</u> ft. below land surface measured on mo/day/yr <u>12/05/09</u> Pump test data: Well water was _____ ft. after _____ hours pumping _____ gpm EST. YIELD _____ gpm. Well water was _____ ft. after _____ hours pumping _____ gpm Bore Hole Diameter <u>8.25</u> in. to <u>12</u> ft., and _____ in. to _____ ft. WELL WATER TO BE USED AS: ☐ Public water supply ☐ Geothermal ☐ Injection well ☐ Domestic ☐ Feedlot ☐ Oil field water supply ☐ Dewatering ☐ Other (Specify below) ☐ Irrigation ☐ Industrial ☐ Domestic-lawn & garden ☒ Monitoring well <u>MW-8</u> Was a chemical/bacteriological sample submitted to Department? ☐ Yes ☒ No If yes, mo/day/yr sample was submitted _____ Water well disinfected? ☐ Yes ☒ No	
5 TYPE OF CASING USED: ☐ Steel ☒ PVC ☐ Other _____ CASING JOINTS: ☐ Glued ☐ Clamped ☐ Welded ☒ Threaded Casing diameter <u>2</u> in. to <u>14.12</u> ft., Diameter _____ in. to _____ ft., Diameter _____ in. to _____ ft. Casing height above land surface <u>0</u> in., Weight _____ lbs./ft., Wall thickness or gauge No. <u>Sch. 40</u> TYPE OF SCREEN OR PERFORATION MATERIAL: ☐ Steel ☐ Stainless Steel ☒ PVC ☐ Other (Specify) _____ ☐ Brass ☐ Galvanized Steel ☐ None used (open hole) SCREEN OR PERFORATION OPENINGS ARE: ☐ Continuous slot ☒ Mill slot ☐ Gauze wrapped ☐ Torch cut ☐ Drilled holes ☐ None (open hole) ☐ Louvered shutter ☐ Key punched ☐ Wire wrapped ☐ Saw cut ☐ Other (specify) _____ SCREEN-PERFORATED INTERVALS: From <u>5</u> ft. to <u>12</u> ft., From _____ ft. to _____ ft. From _____ ft. to _____ ft., From _____ ft. to _____ ft. GRAVEL PACK INTERVALS: From <u>3</u> ft. to <u>12</u> ft., From _____ ft. to _____ ft. From _____ ft. to _____ ft., From _____ ft. to _____ ft.	
6 GROUT MATERIAL: ☐ Neat cement ☐ Cement grout ☒ Bentonite ☐ Other <u>Concrete from 0 to 1ft.</u> Grout Intervals: From <u>1</u> ft. to <u>3</u> ft., From _____ ft. to _____ ft., From _____ ft. to _____ ft. What is the nearest source of possible contamination: ☐ Septic tank ☐ Lateral lines ☐ Pit privy ☐ Livestock pens ☐ Insecticide storage ☐ Other (specify below) ☐ Sewer lines ☐ Cesspool ☐ Sewage lagoon ☒ Fuel storage ☐ Abandoned water well ☐ Watertight sewer lines ☐ Seepage pit ☐ Feedyard ☐ Fertilizer storage ☐ Oil well/gas well _____ Direction from well _____ Distance from well _____	
<table border="1" style="width: 100%; border-collapse: collapse;"> <thead> <tr> <th>FROM</th> <th>TO</th> <th>LITHOLOGIC LOG</th> <th>FROM</th> <th>TO</th> <th>LITHO. LOG (cont.) or PLUGGING INTERVALS</th> </tr> </thead> <tbody> <tr> <td>0</td> <td>1</td> <td>Asphalt</td> <td></td> <td></td> <td></td> </tr> <tr> <td>1</td> <td>5</td> <td>Brown CLAY</td> <td></td> <td></td> <td></td> </tr> <tr> <td>5</td> <td>11.5</td> <td>Gray CLAY</td> <td></td> <td></td> <td></td> </tr> <tr> <td>11.5</td> <td>12</td> <td>Red-brown Limestone</td> <td></td> <td></td> <td></td> </tr> <tr><td> </td><td> </td><td> </td><td> </td><td> </td><td> </td></tr> <tr><td> </td><td> </td><td> </td><td> </td><td> </td><td> </td></tr> <tr><td> </td><td> </td><td> </td><td> </td><td> </td><td> </td></tr> <tr><td> </td><td> </td><td> </td><td> </td><td> </td><td> </td></tr> <tr><td> </td><td> </td><td> </td><td> </td><td> </td><td> </td></tr> <tr><td> </td><td> </td><td> </td><td> </td><td> </td><td> </td></tr> <tr><td> </td><td> </td><td> </td><td> </td><td> </td><td> </td></tr>
CORRECTED	
7 CONTRACTOR'S OR LANDOWNER'S CERTIFICATION: This water well was ☒ constructed, ☐ reconstructed, or ☐ plugged under my jurisdiction and was completed on (mo/day/year) <u>12-3-09</u> and this record is true to the best of my knowledge and belief. Kansas Water Well Contractor's License No. <u>759</u> This Water Well Record was completed on (mo/day/year) <u>12-12-09</u> under the business name of <u>RAZEK Environmental, LLC</u> by (signature) <u>[Signature]</u>	
INSTRUCTIONS: Use typewriter or ball point pen. <u>PLEASE PRESS FIRMLY</u> and <u>PRINT</u> clearly. Please fill in blanks and check the correct answers. Send three copies (white, blue, pink) to Kansas Department of Health and Environment, Bureau of Water, Geology Section, 1000 SW Jackson St., Suite 420, Topeka, Kansas 66612-1367. Telephone 785-296-5522. Send one copy to WATER WELL OWNER and retain one for your records. Include fee of \$5.00 for each <u>constructed</u> well. Visit us at http://www.kdheks.gov/waterwell/index.html .	

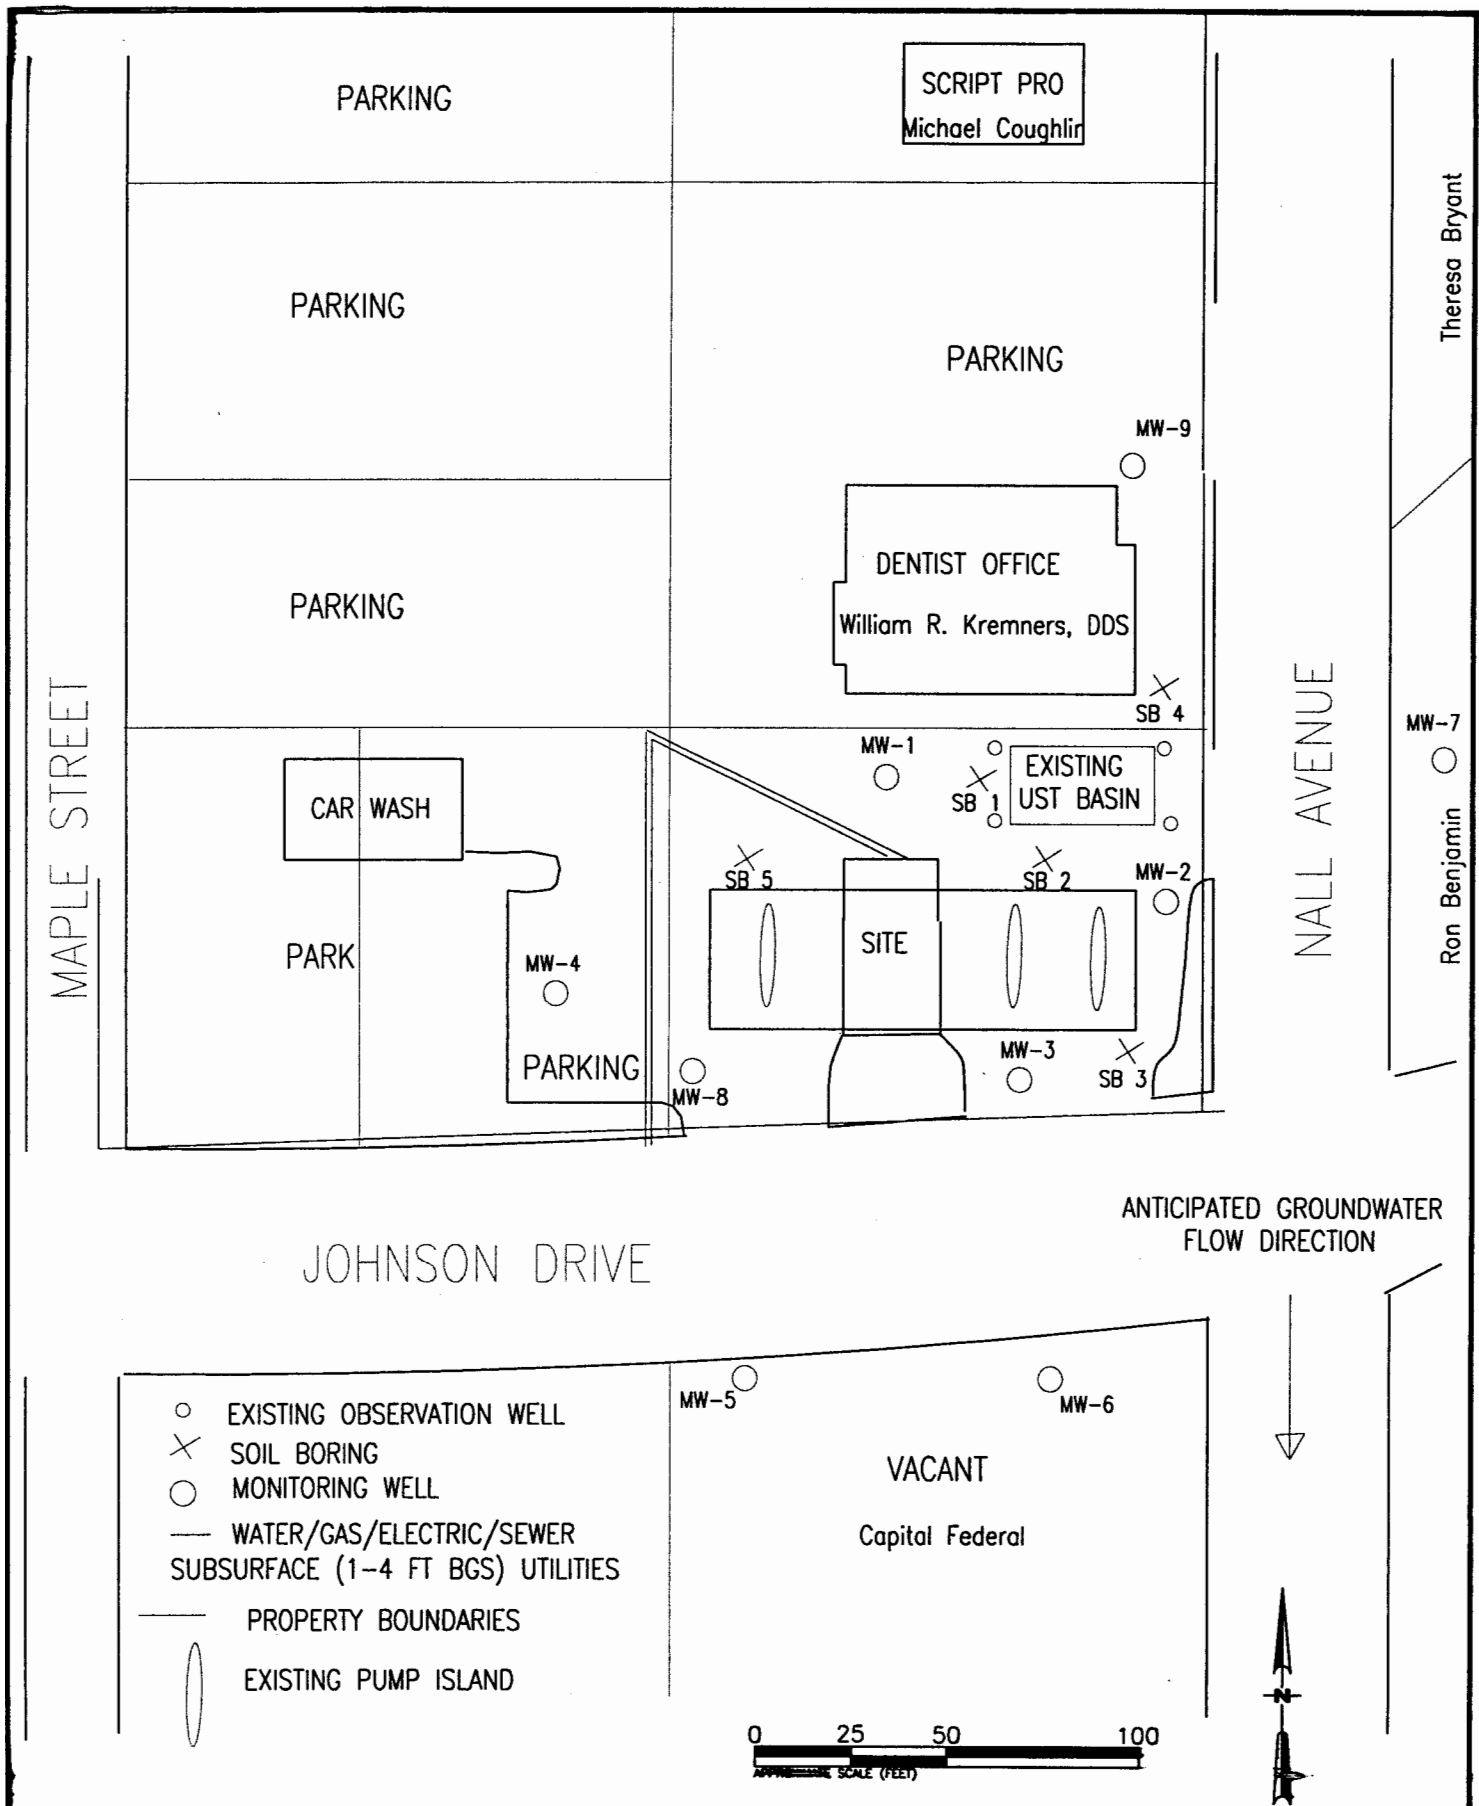

PROJ. # 17102596	PAGE #	BEK/Terranext	FIGURE 2 SITE PLAN JOHNSON DRIVE BP 5500 JOHNSON DRIVE MISSION, KS U4-046-14020
SCALE: AS SHOWN	DRAWN BY: RB		
FILE NO.	DESIGNED BY:		
DATE: 9-30-09	APPROVED BY:		