


Division of Water Resources App. No.

KSA 82a-1212

Check: ☒ White Copy, ☐ Blue Copy, ☐ Pink Copy

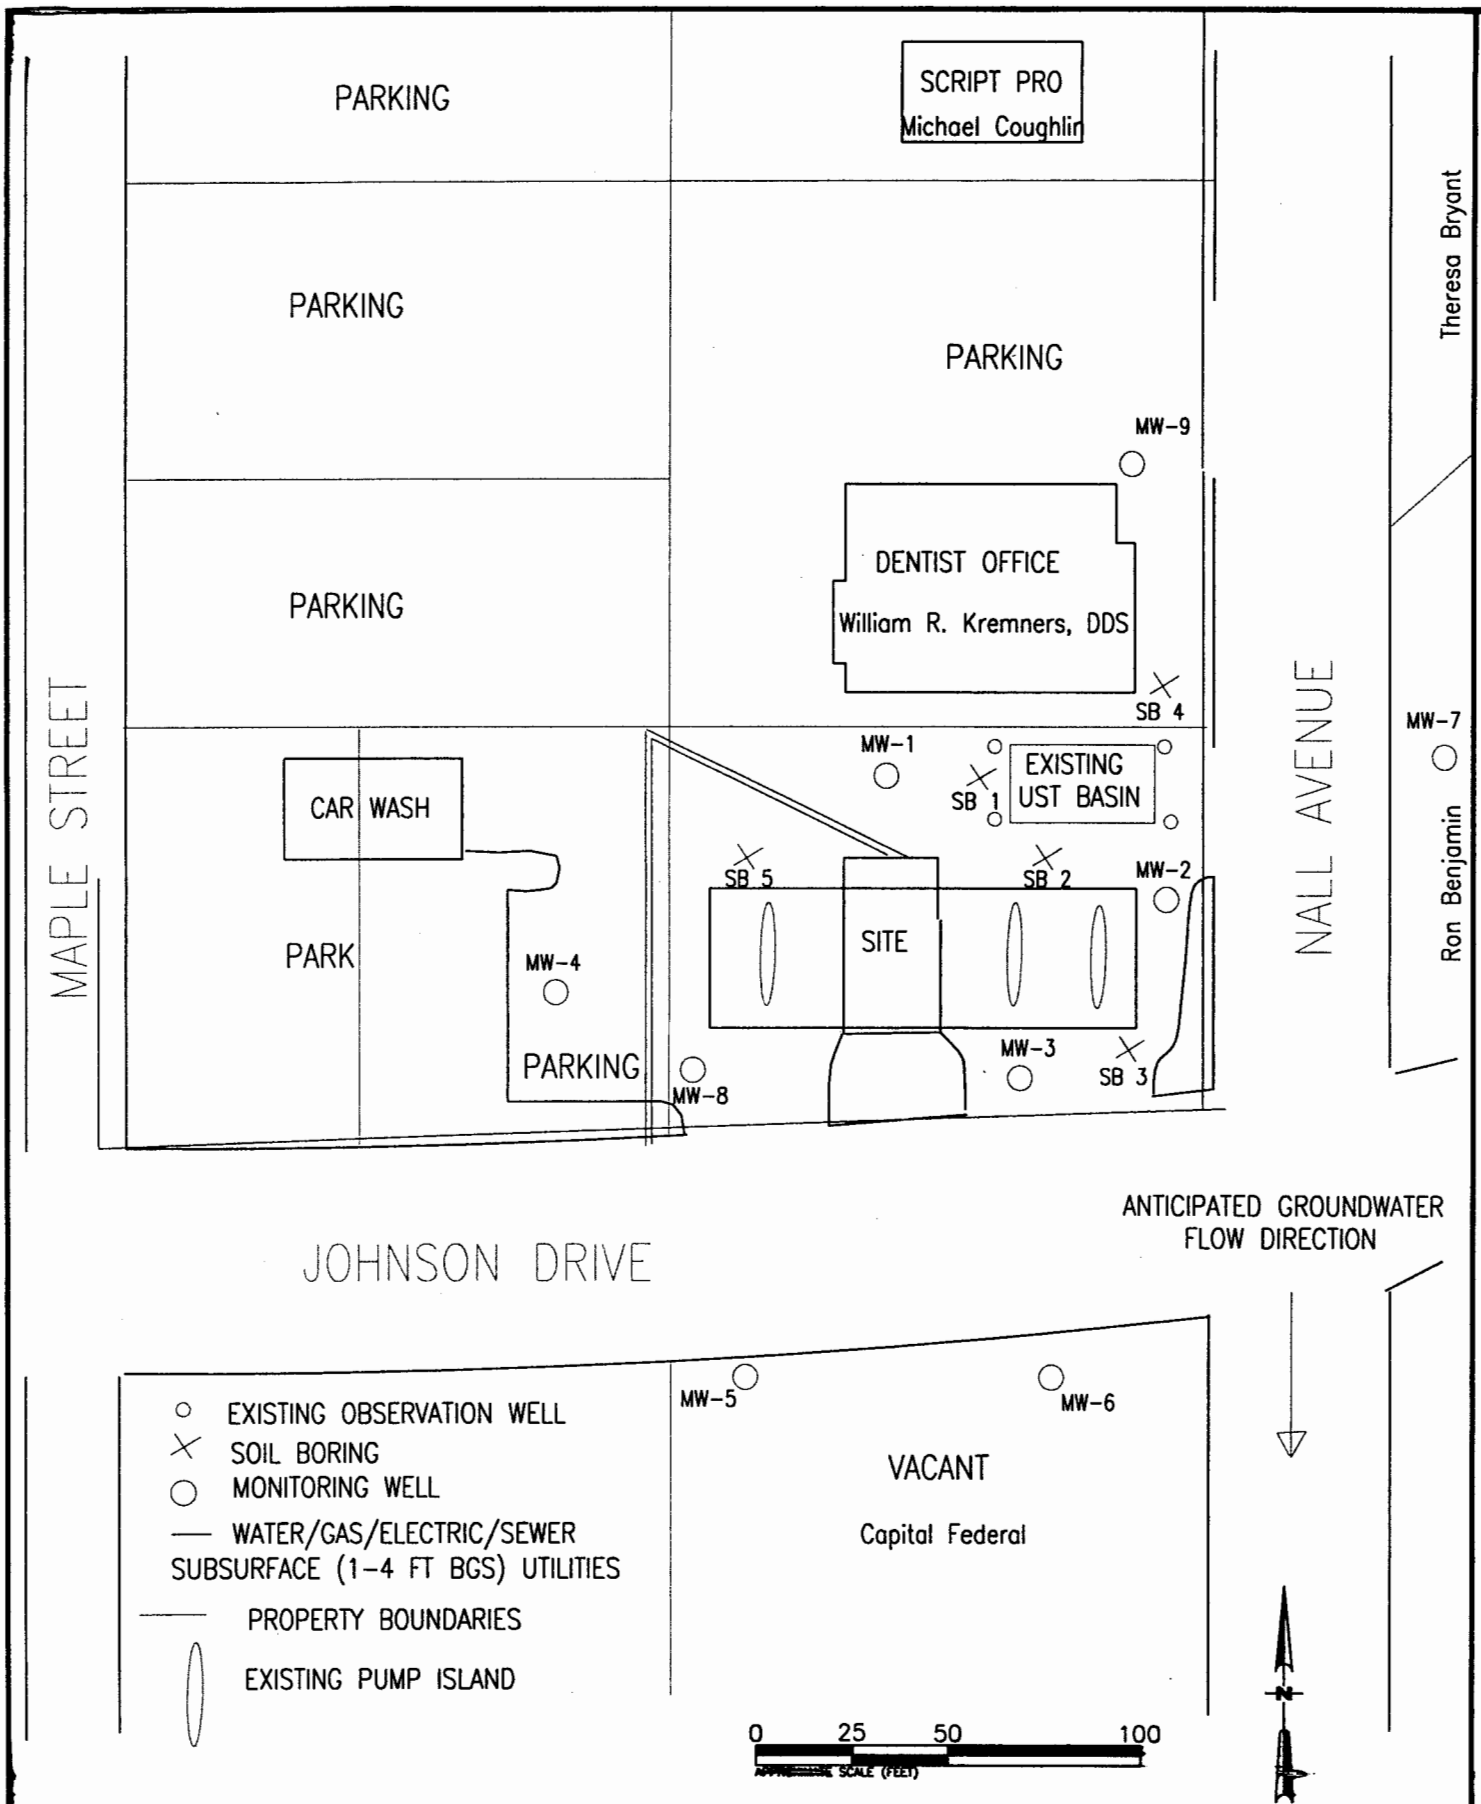

PROJ. # 17102596	PAGE #	BE K/Terranext	FIGURE 2 SITE PLAN JOHNSON DRIVE BP 5500 JOHNSON DRIVE MISSION, KS U4-046-14020
SCALE: AS SHOWN	DRAWN BY: RB		
FILE NO.	DESIGNED BY:		
DATE: 9-30-09	APPROVED BY:		