


Division of Water Resources App. No.

KSA 82a-1212

Check: ☒ White Copy, ☐ Blue Copy, ☐ Pink Copy

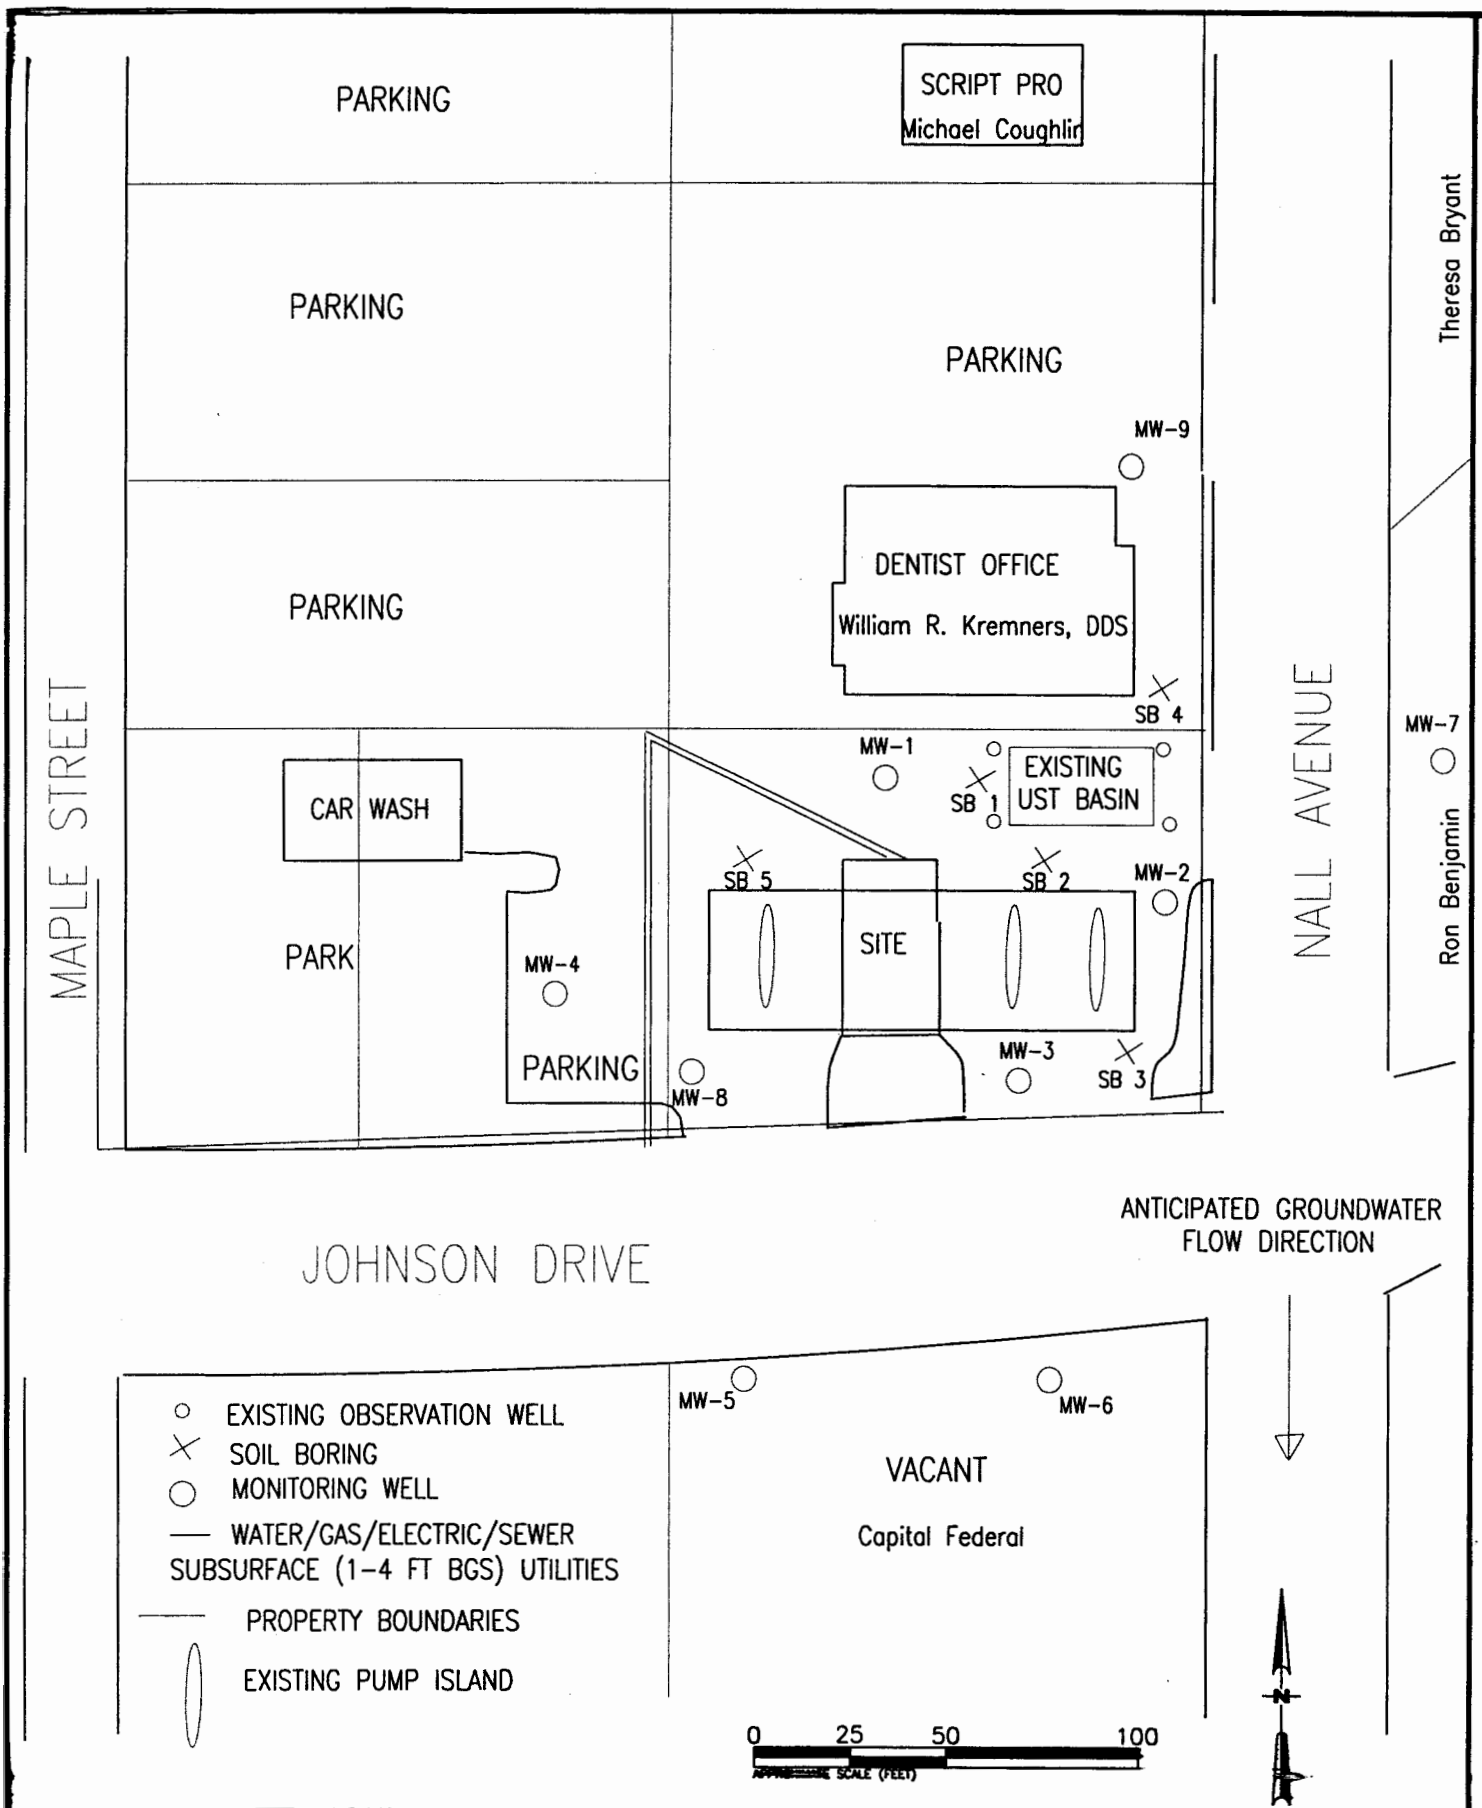

PROJ. # 17102596	PAGE #
SCALE: AS SHOWN	DRAWN BY: RB
FILE NO.	DESIGNED BY:
DATE: 9-30-09	APPROVED BY:

BEK/Terranext

FIGURE 2
SITE PLAN
JOHNSON DRIVE BP
5500 JOHNSON DRIVE
MISSION, KS
U4-046-14020