


Division of Water Resources App. No.

INSTRUCTIONS: Use typewriter or ball point pen. PLEASE PRESS FIRMLY and PRINT clearly. Please fill in blanks and check the correct answers. Send three copies (white, blue, pink) to Kansas Department of Health and Environment, Bureau of Water, Geology Section, 1000 SW Jackson St., Suite 420, Topeka, Kansas 66612-1367. Telephone 785-296-5522. Send one copy to WATER WELL OWNER and retain one for your records. Include fee of \$5.00 for each constructed well. Visit us at <http://www.kdheks.gov/waterwell/index.html>.

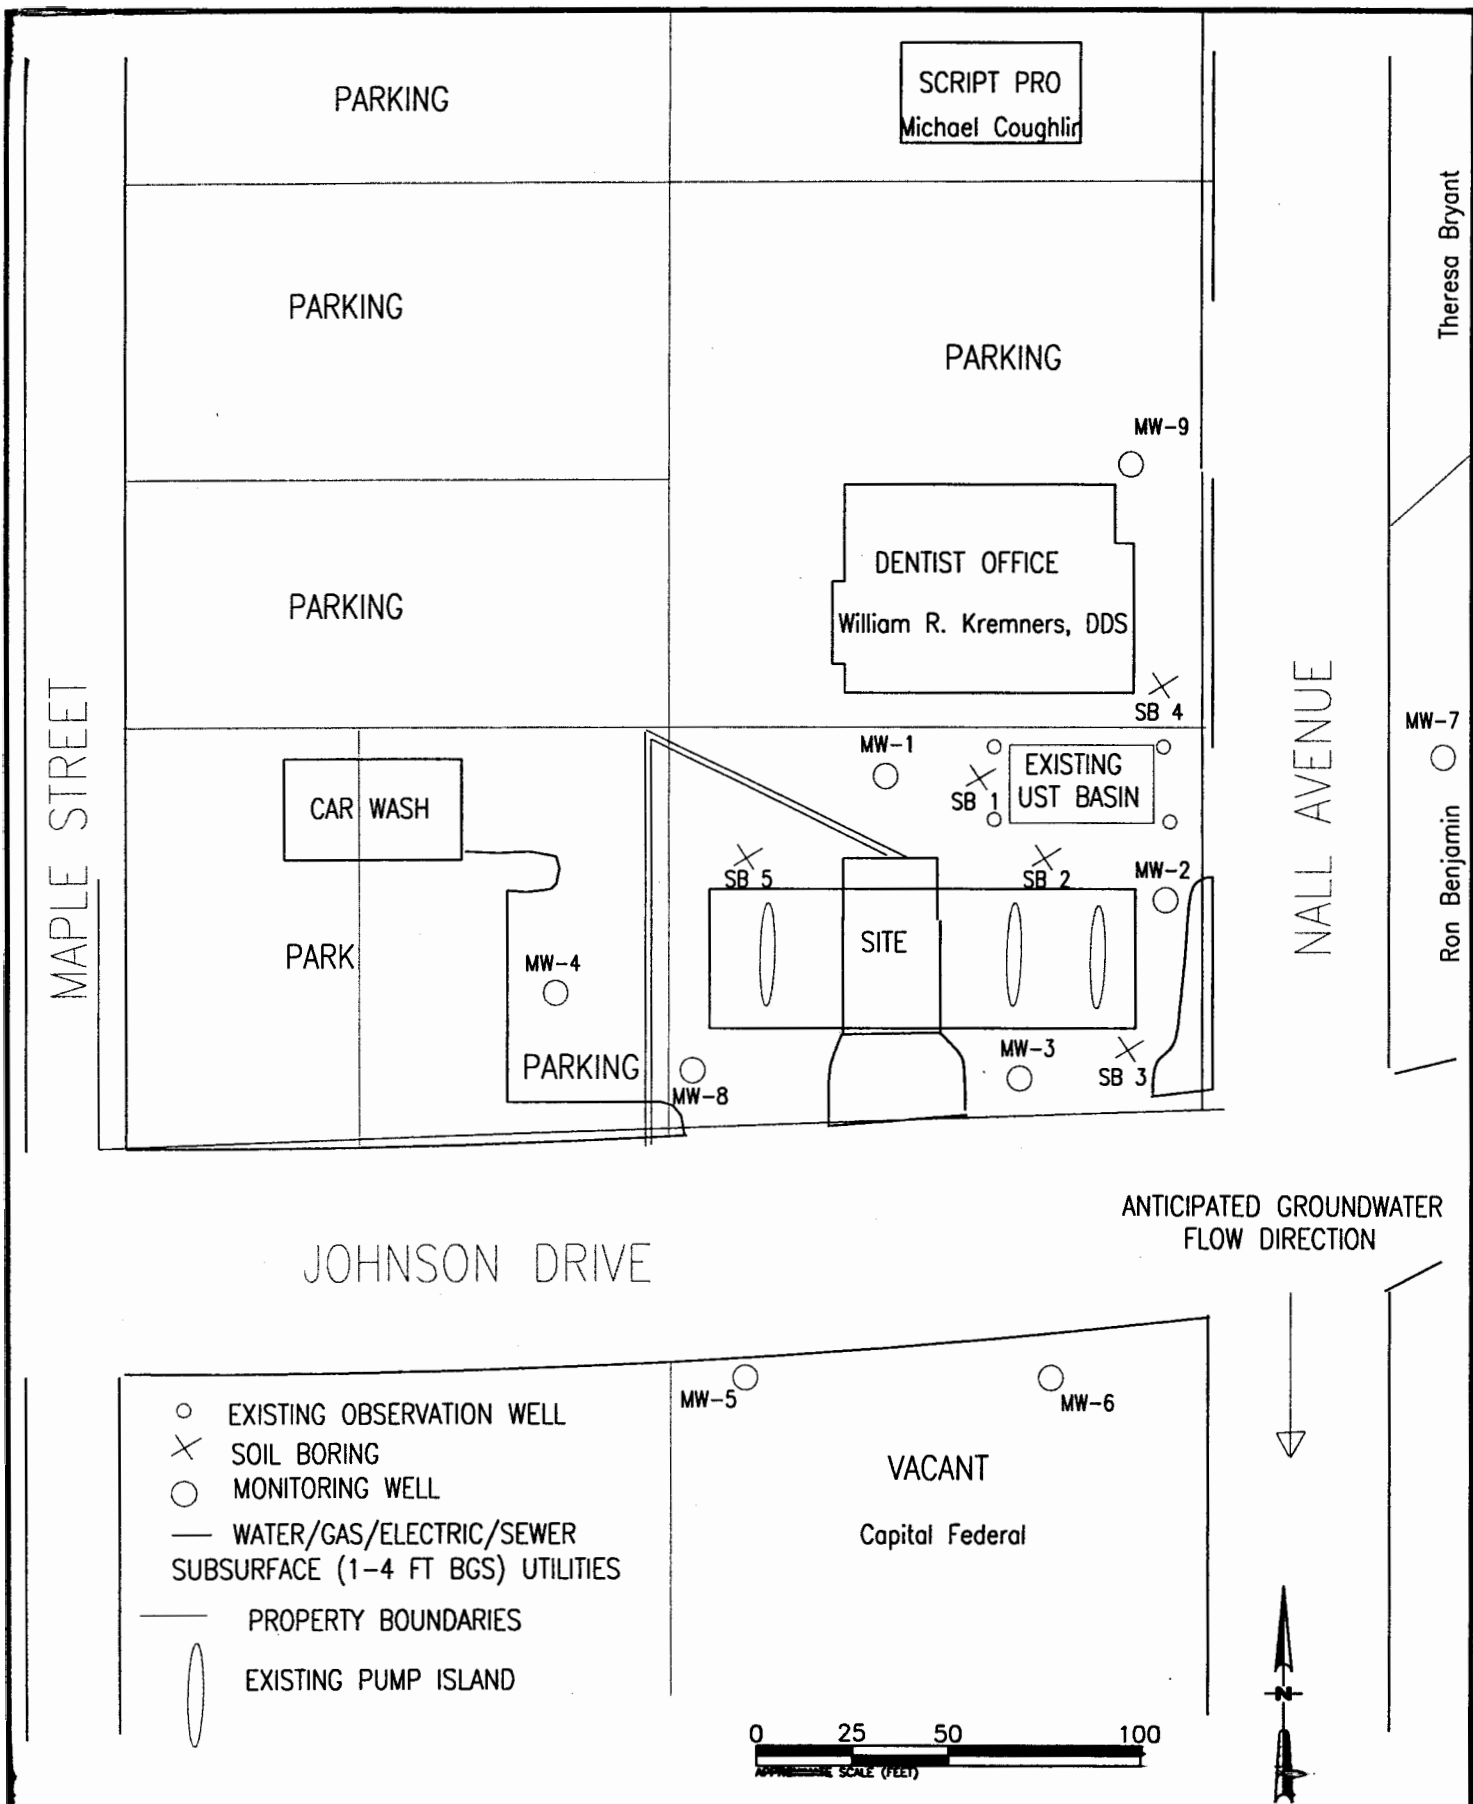

PROJ. # 17102596

PAGE #

SCALE: AS SHOWN

DRAWN BY: RB

FILE NO.

DESIGNED BY:

DATE: 9-30-09

APPROVED BY:

BE K / TerraNext

FIGURE 2
SITE PLAN
JOHNSON DRIVE BP
5500 JOHNSON DRIVE
MISSION, KS
U4-046-14020