


Division of Water Resources App. No.

Check: ☐ White Copy, ☐ Blue Copy, ☐ Pink Copy

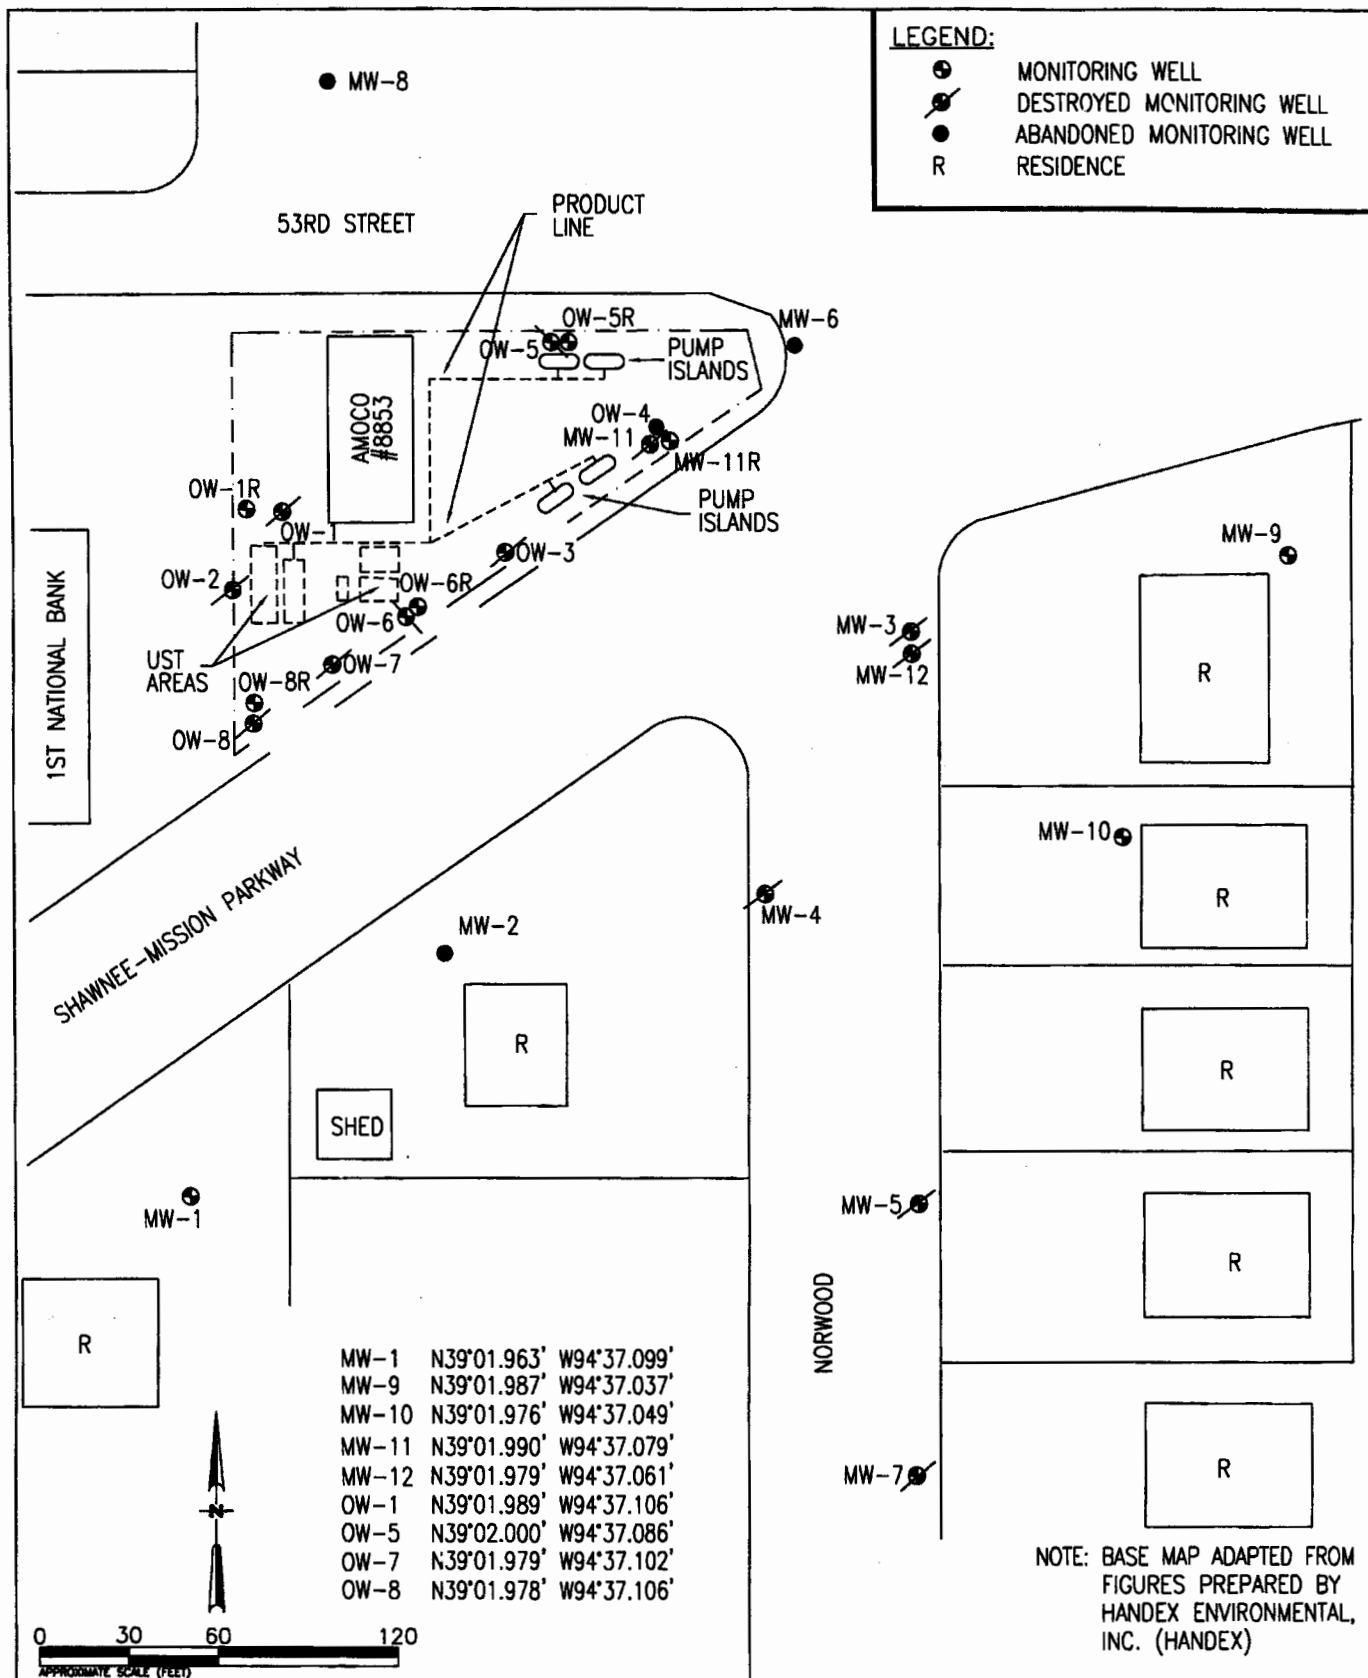

PROJ. # 17102284	PAGE #
SCALE: AS SHOWN	DRAWN BY: RAB/KMT
FILE NO. 2284-F1	DESIGNED BY:
DATE: 8/1/07	APPROVED BY:



FIGURE 1
SITE PLAN

AMOCO Station No. 8853
2814 SHAWNEE MISSION PARKWAY
FAIRWAY, KANSAS