

MW-24

Check: ☐ White Copy, ☐ Blue Copy, ☐ Pink Copy

				LOG OF BORING NO: MW-24		SHEET NUMBER 1 OF 1	
PROJECT NAME: Amoco #9606				DRILLING/PROBING CONTRACTOR: PSA Environmental		Water Level Data	
PROJECT LOCATION: 3860 W 95th St				DRILLING METHOD / BORE DIAMETER: 8.25"/4.25"		Date Time Depth	
Lenexa, Kansas				SAMPLING METHOD: closed piston			
PROJECT NUMBER: 17102312				TOTAL DEPTH (feet): 9.68		Survey Data	
GEOLOGIST: M. Watson				START DATE: 4/23/2012		Ground Surface:	
DRILLER:				COMPLETION DATE: 4/23/2012		Top Of Casing:	
						Ground Water:	
SAMPLE DEPTH AND TIME	PID (PPMV)	RECOVERY (FEET)	DEPTH (FEET)	WELL CONSTRUCTION	GEOLOGIC DESCRIPTION (NAME, color, particle size, characteristics)	NOTES:	
1232	6.9	2/4	1	CONCRETE	Asphalt Surface		
			2	HYDRATED BENTONITE	FILL: sand with gravels		
			3				
			4				
1236	0.9	2/4	5	10-20 SAND FILTER PACK		2-3 ft, no odor	
			6			4-5.5 ft, no odor	
			7			Saturated ↓	
			8				
1239	NR	1/4	9	2" Diameter Sch. 40 PVC Screen			
			10				
			11				
			12		FILL SAND	Total Well Depth = 10 ft bgs	
1243			13		sampled to 12 ft bgs		
			14				
			15				
			16				
			17				
			18				
			19				
			20				
			21				
			22				
			23				
			24				
			25				

LEGEND:
SS - Split Spoon
PID - Photoionization Detector
NR - No Recovery


- Concrete
 - Flush Mount Vault
 - Grout

- Bentonite Chip Seal
 - Filter Pack
 - Well Screen

ST - Shelby Tube
HSA - Hollow Stem Augers
PPMV - Parts Per Million by Volume

FLUSH-MOUNT WELL CONSTRUCTION DETAIL

(NOT TO SCALE)

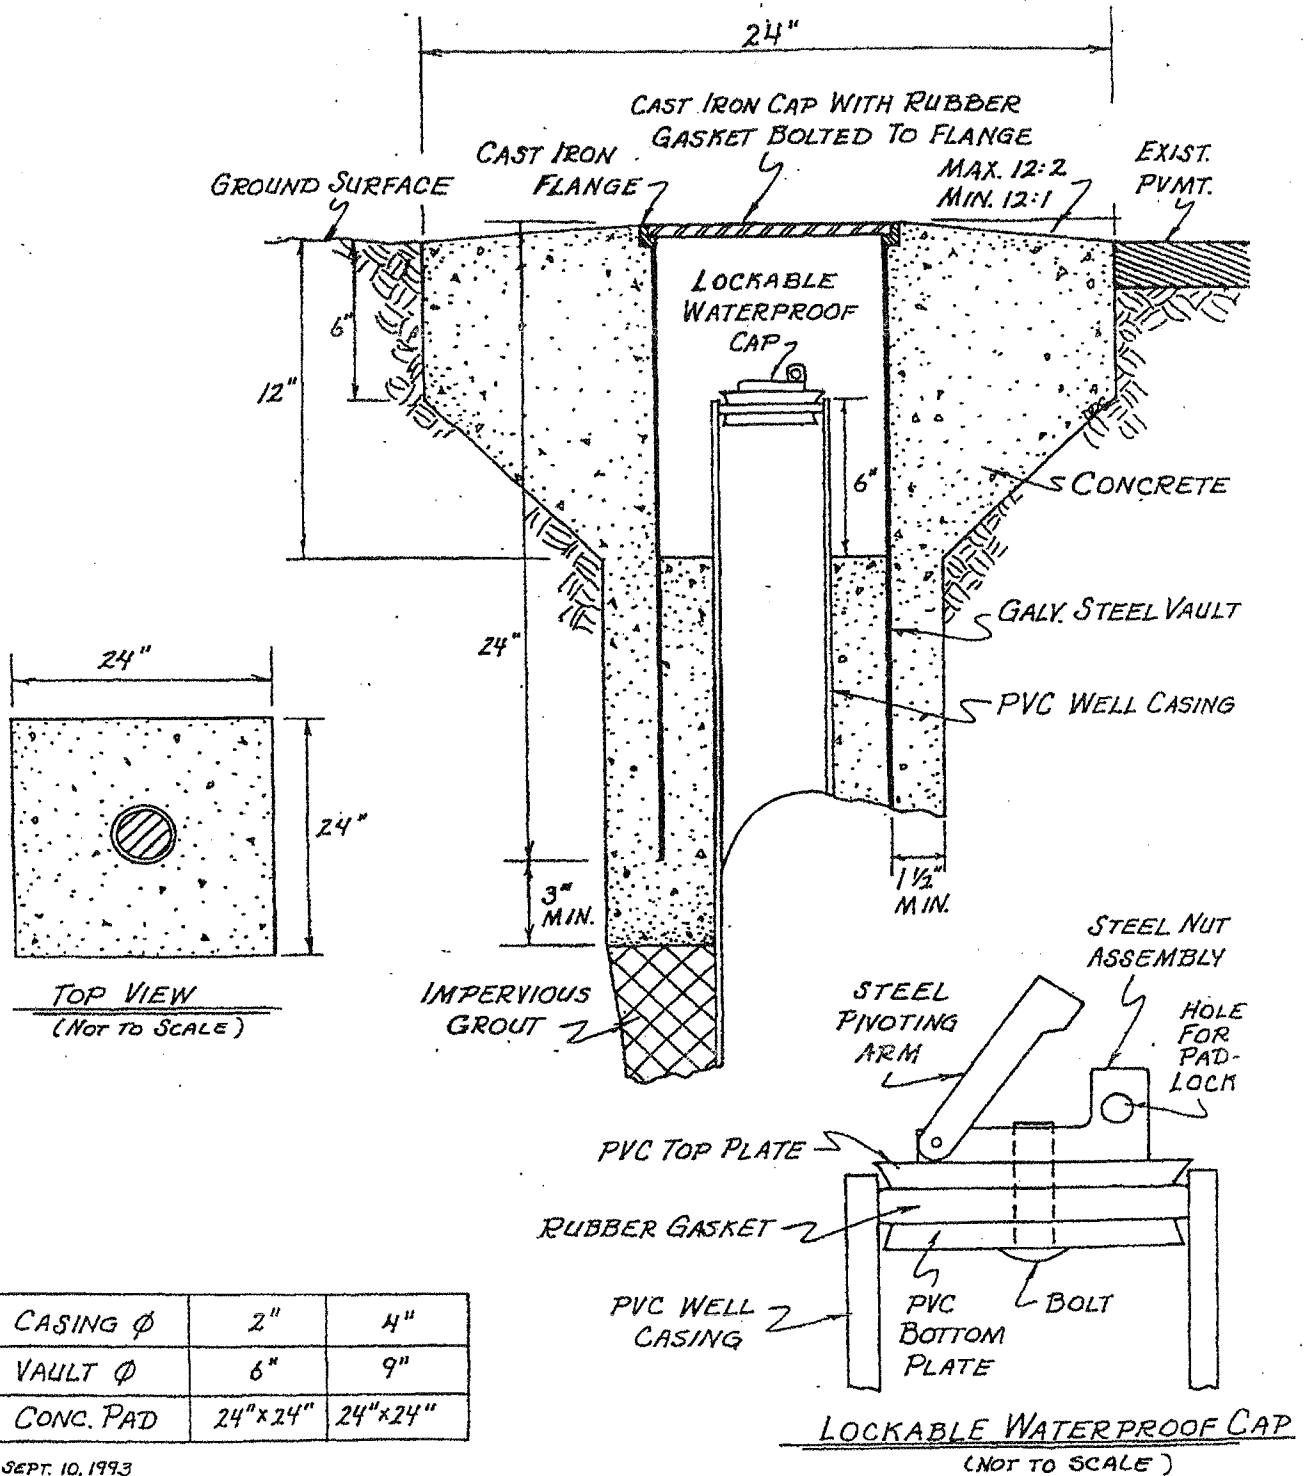

SEPT. 10, 1993