


7446 Metcalf, Overland Park, KS

Board of Agriculture, Division of Water Resources
Application Number:

4	DEPTH OF COMPLETED WELL	10	ft. ELEVATION:	1031.65
---	-------------------------	----	----------------	---------

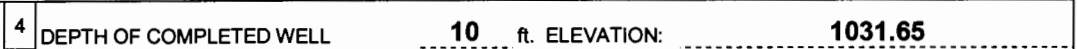

Was a chemical/bacteriological sample submitted to Department? Yes _____ No **X** If yes, mo/day/yr sample was Submitted _____ Water Well Disinfected? Yes _____ No **X**

SAND PACK INTERVALS:		From 1.5 ft. to 10 ft.	From _____ ft. to _____ ft.
		From _____ ft. to _____ ft.	From _____ ft. to _____ ft.

Direction from well?		How many feet?		PLUGGING INTERVALS	
FROM	TO	CODE	LITHOLOGIC LOG	FROM	TO

[illegible]

INSTRUCTIONS: Please fill in blanks and circle the correct answers. Send three copies to Kansas Department of Health and Environment, Bureau of Water, Topeka, Kansas 66620-0001. Telephone: 913-296-5545. Send one to WATER WELL OWNER and retain one for your records.

SEC