

1 LOCATION OF WATER WELL: County: Johnson	Fraction	Section Number	Township Number	Range Number
	SW¼ NW¼ SW¼ SE¼	20	T 12 S	25 <input checked="" type="checkbox"/> E <input type="checkbox"/> W


Street/Rural Address of Well Location; if unknown, distance & direction from nearest town or intersection: If at owner's address, check here   
7733 Metcalf Ave., Overland Park KS

Global Positioning Systems (GPS) information:  
Latitude: NA (in decimal degrees)  
Longitude: NA (in decimal degrees)  
Elevation: NA

Horizontal Datum  WGS84,  NAD83,  NAD27  
Collection Method:

2 WATER WELL OWNER: Jerry B. Kaplan  
RR#, St. Address, Box #: 5508 W. 82nd Terrace  
City, State ZIP Code: Prairie Village, KS 66208

GPS unit (Make/model: \_\_\_\_\_)  
 Digital Map/Photo,  Topographic Map  Land Survey  
Est. Accuracy:  <3 m,  3-5 m,  5-15 m,  >15 m

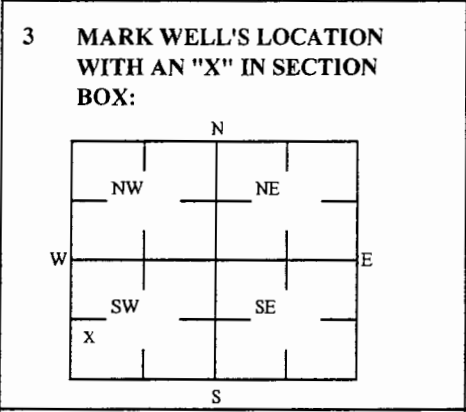

4 DEPTH OF WELL 13.6 ft. MW6  
WELL'S STATIC WATER LEVEL \_\_\_\_\_ ft  
WELL WAS USED AS:  
 Domestic  Public Water Supply  Dewatering  
 Irrigation  Oil Field Water Supply  Monitoring  
 Feedlot  Domestic (Lawn & Garden)  Injection Well  
 Industrial  Air Conditioning  Other \_\_\_\_\_  
Was a chemical/bacteriological sample submitted to Department? Yes  No

5 TYPE OF BLANK CASING USED:  
 Steel  RMP (SR)  Wrought  Fiberglass  Other (Specific below)  
 PVC  ABS  Asbestos-Cement  Concrete Tile  
Blank casing diameter 2 in. Was casing pulled? Yes  No  If yes, how much 13.6'  
Casing height above or below land surface NA in.

6 GROUT PLUG MATERIAL:  Neat cement  Cement grout  Bentonite  Other Asphalt: 0-0.2'; Concrete: 0.2-0.7'; Soil: 0.7-3'  
Grout Plug Intervals: From 3 ft to 13.6 ft, From \_\_\_\_\_ ft to \_\_\_\_\_ ft, From \_\_\_\_\_ ft to \_\_\_\_\_ ft  
What is the nearest source of possible contamination:  
 Septic tank  Seepage pit  Fuel storage  Other (specify below) \_\_\_\_\_  
 Sewer lines  Pit privy  Fertilizer storage \_\_\_\_\_  
 Watertight sewer lines  Sewage lagoon  Insecticide storage \_\_\_\_\_  
 Lateral lines  Feed yard  Abandoned water well Direction from well? \_\_\_\_\_  
 Cess pool  Livestock pens  Oil well/Gas well How many feet? \_\_\_\_\_

FROM	TO	PLUGGING MATERIALS	FROM	TO	PLUGGING MATERIALS
0	0.2	Asphalt			
0.2	0.7	Concrete			
0.7	3	Soil			
3	13.6	Bentonite			

KDHE ID: J D Byrider: U4-046-14580

7 CONTRACTOR'S OR LANDOWNER'S CERTIFICATION: This water well was plugged under my jurisdiction and was completed on (mo/day/year) 1/14/16 and this record is true to the best of my knowledge and belief. Kansas Water Contractor's License No. 757. This Water Well Record was completed on (mo/day/year) 2/10/16 under the business name of Larsen & Associates, Inc. By (signature) \_\_\_\_\_

Send one white copy to Kansas Department of Health & Environment, Geology Section, 4000 SW Jackson Street, Ste. 420, Topeka, KS 66612-1367. Send one copy to WATER WELL OWNER and retain one for your records  
Visit us at <http://www.kdheks.gov/waterwell/index.html> Telephone 785-296-5524.