

**WATER WELL PLUGGING RECORD Form WWC-5P**

KSA 82a-1212 ID NO.

MW-9A

<b>1 LOCATION OF WATER WELL:</b> County: Johnson	Fraction ¼ SE ¼ SE ¼ SE ¼	Section Number 16	Township Number T 12 S	Range Number 25 <input checked="" type="checkbox"/> E <input type="checkbox"/> W
---	------------------------------	----------------------	---------------------------	---

Street/Rural Address of Well Location; if unknown, distance & direction from nearest town or intersection: If at owner's address, check here  Former Phillips 66 Gas Station; 6940 Mission Road; Prairie Village, KS

**Global Positioning Systems (GPS) information:**  
 Latitude: 39.001928 (in decimal degrees)  
 Longitude: -94.630206 (in decimal degrees)  
 Elevation: \_\_\_\_\_  
 Horizontal Datum:  WGS84,  NAD83,  NAD27  
 Collection Method: \_\_\_\_\_

**2 WATER WELL OWNER:** Phillips 66 Company  
 RR#, St. Address, Box #: 420South Keeler Ave. PB 1708-03  
 City, State ZIP Code: Bartlesville, OK 74003

GPS unit (Make/Model: Garmin etrek)  
 Digital Map/Photo,  Topographic Map,  Land Survey  
 Est. Accuracy:  < 3 m,  3-5 m,  5-15 m,  > 15 m

**3 MARK WELL'S LOCATION WITH AN "X" IN SECTION BOX:**

**4 DEPTH OF WELL** 12 ft.  
 WELL'S STATIC WATER LEVEL 4.4 ft  
 WELL WAS USED AS:  
 Domestic  Public Water Supply  Dewatering  
 Irrigation  Oil Field Water Supply  Monitoring  
 Feedlot  Domestic (Lawn & Garden)  Injection Well  
 Industrial  Air Conditioning  Other \_\_\_\_\_  
 Was a chemical/bacteriological sample submitted to Department? Yes  No

**5 TYPE OF BLANK CASING USED:**

Steel  RMP (SR)  Wrought  Fiberglass  Other (Specify below) \_\_\_\_\_  
 PVC  ABS  Asbestos-Cement  Concrete Tile

Blank casing diameter 2 in. Was casing pulled? Yes  No  If yes, how much all  
 Casing height above or below land surface -6 in.

**6 GROUT PLUG MATERIAL:**  Neat cement  Cement grout  Bentonite  Other Concrete

Grout Plug Intervals: From 0 ft. to 2 ft., From 2 ft. to 12 ft., From — ft. to — ft.

What is the nearest source of possible contamination:  
 Septic tank  Seepage pit  Fuel storage  Other (specify below) \_\_\_\_\_  
 Sewer lines  Pit privy  Fertilizer storage  
 Watertight sewer lines  Sewage lagoon  Insecticide storage  
 Lateral lines  Feedyard  Abandoned water well Direction from well? North  
 Cess pool  Livestock pens  Oil well/Gas well How many feet? 725 Feet


FROM	TO	PLUGGING MATERIALS	FROM	TO	PLUGGING MATERIALS
0	2	Concrete			
2	12	Bentonite			

**7 CONTRACTOR'S OR LANDOWNER'S CERTIFICATION:** This water well was plugged under my jurisdiction and was completed on (mo/day/year) 11/25/2019 and this record is true to the best of my knowledge and belief. Kansas Water Well Contractor's License No. 710. This Water Well Record was completed on (mo/day/year) 11/26/2019 under the business name of Below Ground Surface, Inc. by (signature) Clay K. Hewitt

Send one white copy to Kansas Department of Health & Environment, Geology Section, 1000 SW Jackson Street, Ste. 420, Topeka, KS 66612-1367. Send one copy to WATER WELL OWNER and retain one for your records.  
 Visit us at <http://www.kdheks.gov/waterwell/index.html> Telephone 785-296-5524.

**LEGEND:**


- MW-1 MONITORING WELL LOCATION
- TOC TOP OF CASING ELEVATION IN FEET ABOVE MEAN SEA LEVEL (MSL)
- SWL STATIC WATER LEVEL IN FEET MSL
- GROUNDWATER CONTOUR IN FEET (INTERVAL= 2.0 FT)
- GROUNDWATER FLOW DIRECTION
- NATURAL GAS
- STORM DRAIN / SEWER
- OVERHEAD ELECTRIC
- WATER
- FIBER OPTICS
- PROPERTY LINE
- PROJECT BENCHMARK  
ELEVATION = 923.82
- RESIDENTIAL
- COMMERCIAL
- BUILDING WITH BASEMENT
- \* NOT USED IN GROUNDWATER CALCULATIONS

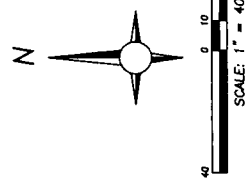

# 1.0 ATC

**GROUNDWATER FLOW**  
**DECEMBER 13, 2018**  
 FORMER PHILLIPS 66 STATION #8668 R#&R #5279  
 6940 MISSION ROAD  
 PRAIRIE VILLAGE, KANSAS

PROJECT NUMBER: P66R5279	DOCUMENT: GROUNDWATER MONITORING REPORT	DRAWN BY: SR 01/03/19
FILE PATH: December 2018 Report.dwg		CHECKED BY: SR 01/03/19

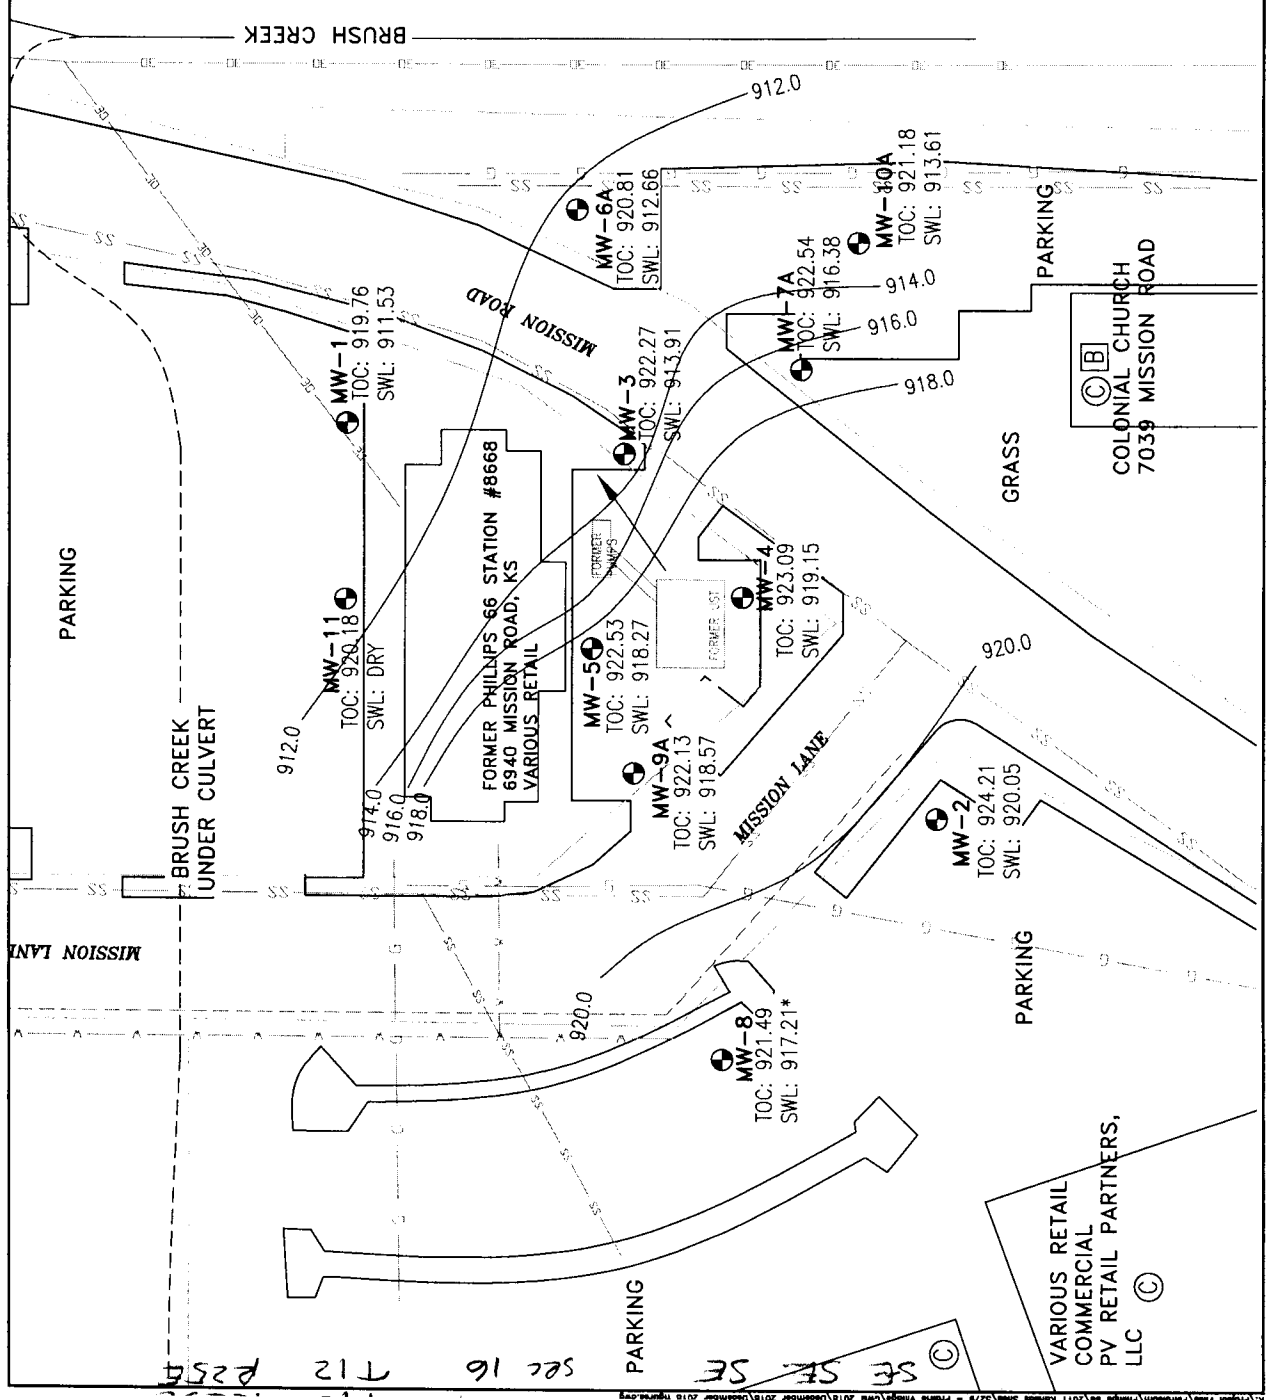

Sec 16 T12 R25E

