

WATER WELL PLUGGING RECORD Form WWC-5P

KSA 82a-1212 ID NO.

MW- 6A

| | | | | |
|---|------------------------------|----------------------|---------------------------|---|
| 1 LOCATION OF WATER WELL: County: Johnson | Fraction ¼ SE ¼ SE ¼ SE ¼ | Section Number 16 | Township Number T 12 S | Range Number 25 <input checked="" type="checkbox"/> E <input type="checkbox"/> W |
|---|------------------------------|----------------------|---------------------------|---|


Street/Rural Address of Well Location; if unknown, distance & direction from nearest town or intersection: If at owner's address, check here Former Phillips 66 Gas Station; 6940 Mission Road; Prairie Village, KS

Global Positioning Systems (GPS) information:
 Latitude: 39.0019 (in decimal degrees)
 Longitude: -94.6300 (in decimal degrees)
 Elevation:
 Horizontal Datum: WGS84, NAD83, NAD27
 Collection Method:

2 WATER WELL OWNER: Phillips 66 Company
 RR#, St. Address, Box #: 420South Keeler Ave. PB 1708-03
 City, State ZIP Code: Bartlesville, OK 74003

GPS unit (Make/Model: Garmin etrek)
 Digital Map/Photo, Topographic Map, Land Survey
 Est. Accuracy: < 3 m, 3-5 m, 5-15 m, > 15 m

3 MARK WELL'S LOCATION WITH AN "X" IN SECTION BOX:

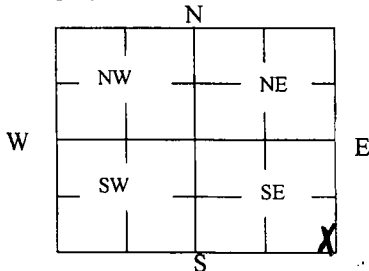

4 DEPTH OF WELL 12 ft.
 WELL'S STATIC WATER LEVEL 8.5 ft

WELL WAS USED AS:

- | | | |
|-------------------------------------|---|--|
| <input type="checkbox"/> Domestic | <input type="checkbox"/> Public Water Supply | <input type="checkbox"/> Dewatering |
| <input type="checkbox"/> Irrigation | <input type="checkbox"/> Oil Field Water Supply | <input checked="" type="checkbox"/> Monitoring |
| <input type="checkbox"/> Feedlot | <input type="checkbox"/> Domestic (Lawn & Garden) | <input type="checkbox"/> Injection Well |
| <input type="checkbox"/> Industrial | <input type="checkbox"/> Air Conditioning | <input type="checkbox"/> Other _____ |

Was a chemical/bacteriological sample submitted to Department? Yes No

5 TYPE OF BLANK CASING USED:

- Steel RMP (SR) Wrought Fiberglass Other (Specify below)
 PVC ABS Asbestos-Cement Concrete Tile

Blank casing diameter 2 in. Was casing pulled? Yes No If yes, how much all
 Casing height above or below land surface -6 in.

6 GROUT PLUG MATERIAL: Neat cement Cement grout Bentonite Other Top Soil

Grout Plug Intervals: From 0 ft. to 3 ft., From 3 ft. to 12 ft., From — ft. to — ft.

What is the nearest source of possible contamination:


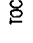














- | | | | |
|---|---|--|--|
| <input type="checkbox"/> Septic tank | <input type="checkbox"/> Seepage pit | <input checked="" type="checkbox"/> Fuel storage | <input type="checkbox"/> Other (specify below) |
| <input type="checkbox"/> Sewer lines | <input type="checkbox"/> Pit privy | <input type="checkbox"/> Fertilizer storage | |
| <input type="checkbox"/> Watertight sewer lines | <input type="checkbox"/> Sewage lagoon | <input type="checkbox"/> Insecticide storage | |
| <input type="checkbox"/> Lateral lines | <input type="checkbox"/> Feedyard | <input type="checkbox"/> Abandoned water well | Direction from well? <u>North - NW</u> |
| <input type="checkbox"/> Cess pool | <input type="checkbox"/> Livestock pens | <input type="checkbox"/> Oil well/Gas well | How many feet? <u>750 Feet</u> |


| FROM | TO | PLUGGING MATERIALS | FROM | TO | PLUGGING MATERIALS |
|----------|-----------|--------------------|------|----|--------------------|
| <u>0</u> | <u>3</u> | <u>Top Soil</u> | | | |
| <u>3</u> | <u>12</u> | <u>Bentonite</u> | | | |
| | | | | | |
| | | | | | |
| | | | | | |

7 CONTRACTOR'S OR LANDOWNER'S CERTIFICATION: This water well was plugged under my jurisdiction and was completed on (mo/day/year) 11/25/2019 and this record is true to the best of my knowledge and belief. Kansas Water Well Contractor's License No. 710. This Water Well Record was completed on (mo/day/year) 11/26/2019 under the business name of Below Ground Surface, Inc. by (signature) Cray K. Hewitt

Send one white copy to Kansas Department of Health & Environment, Geology Section, 1000 SW Jackson Street, Ste. 420, Topeka, KS 66612-1367. Send one copy to WATER WELL OWNER and retain one for your records.
 Visit us at <http://www.kdheks.gov/waterwell/index.html> Telephone 785-296-5524.

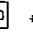LEGEND:

- MW-1  MONITORING WELL LOCATION
- TOC  TOP OF CASING ELEVATION IN FEET ABOVE MEAN SEA LEVEL (MSL)
- SWL  STATIC WATER LEVEL IN FEET MSL
-  GROUNDWATER CONTOUR IN FEET (INTERVAL= 2.0 FT)
-  GROUNDWATER FLOW DIRECTION
-  NATURAL GAS
-  STORM DRAIN / SEWER
-  OVERHEAD ELECTRIC
-  WATER
-  FIBER OPTICS
-  PROPERTY LINE
-  PROJECT BENCHMARK
ELEVATION = 923.82
-  RESIDENTIAL
-  COMMERCIAL
-  BUILDING WITH BASEMENT
-  * NOT USED IN GROUNDWATER CALCULATIONS

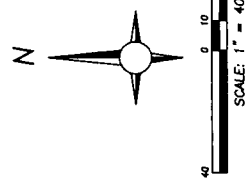


1.0

GROUNDWATER FLOW DECEMBER 13, 2018

FORMER PHILLIPS 66 STATION #8668 R#&R #5279
6940 MISSION ROAD
PRAIRIE VILLAGE, KANSAS

| | | |
|-------------------------------------|--|----------------------------|
| PROJECT NUMBER: P66RS279 | DOCUMENT: GROUNDWATER MONITORING REPORT | DRAWN BY: SR 01/03/19 |
| FILE PATH: December 2018 Report.dwg | | CHECKED BY: SR 01/03/19 |

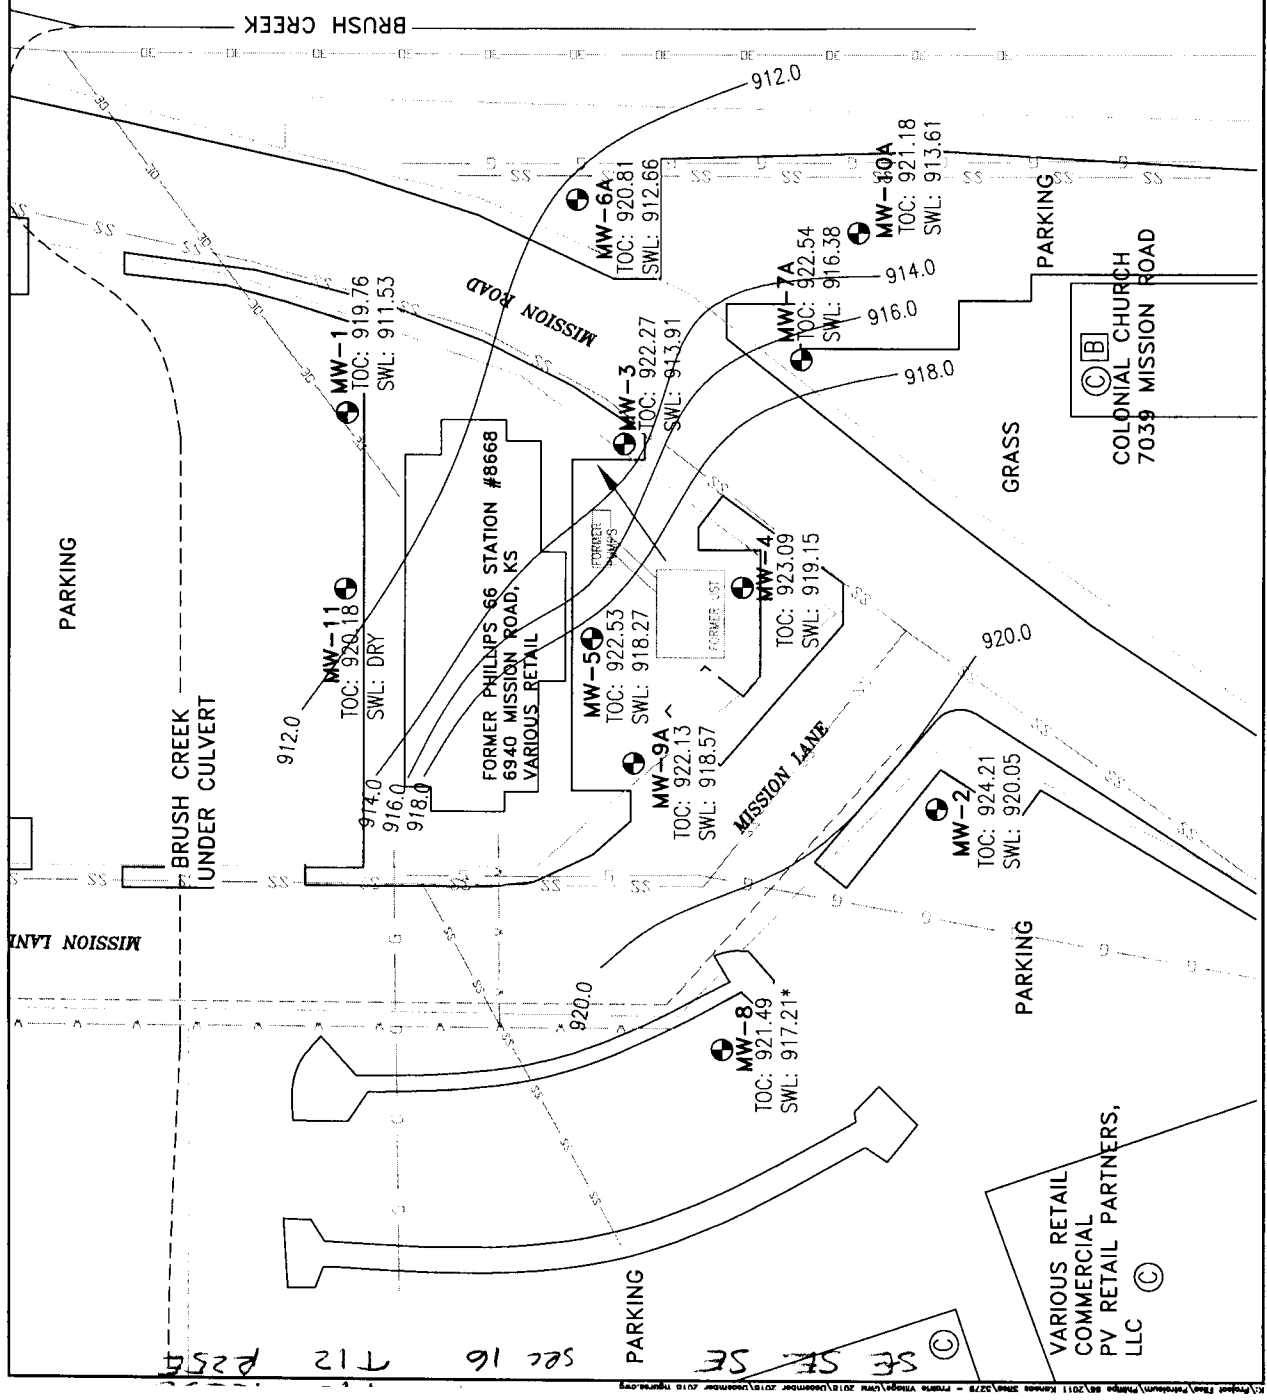

SEC 16 T12 R25E
 SE SE SE SE
