

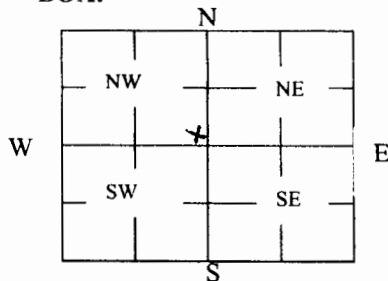
WATER WELL PLUGGING RECORD Form WWC-5P

KSA 82a-1212 ID NO.

MW-12

1 LOCATION OF WATER WELL: County: <u>Johnson</u>	Fraction <u>SE 1/4 SE 1/4 SE 1/4 NW 1/4</u>	Section Number <u>30</u>	Township Number <u>T 12 S</u>	Range Number <u>25</u> ☒ E ☐ W
Street/Rural Address of Well Location; if unknown, distance & direction from nearest town or intersection: If at owner's address, check here ☐ <u>8205 Santa Fe Drive Overland Park, KS</u>		Global Positioning Systems (GPS) information: Latitude: <u>38.979192</u> (in decimal degrees) Longitude: <u>94.677311</u> (in decimal degrees) Elevation: <u>1073.40</u> Horizontal Datum: ☐ WGS84, ☐ NAD83, ☐ NAD27 Collection Method:		

2 WATER WELL OWNER: <u>Town & Country Markets</u> RR#, St. Address, Box #: <u>P.O. Box 17087</u> City, State ZIP Code: <u>Wichita, KS 67217</u>	☐ GPS unit (Make/Model: _____) ☒ Digital Map/Photo, ☐ Topographic Map, ☐ Land Survey Est. Accuracy: ☒ < 3 m, ☐ 3-5 m, ☐ 5-15 m, ☐ > 15 m
--	--

3 MARK WELL'S LOCATION WITH AN "X" IN SECTION BOX:**4 DEPTH OF WELL** 15.5 **ft.**WELL'S STATIC WATER LEVEL 7.09 ft

WELL WAS USED AS:

- ☐
- Domestic
-
- ☐
- Irrigation
-
- ☐
- Feedlot
-
- ☐
- Industrial

- ☐
- Public Water Supply
-
- ☐
- Oil Field Water Supply
-
- ☐
- Domestic (Lawn & Garden)
-
- ☐
- Air Conditioning

- ☒
- Dewatering
-
- ☐
- Monitoring
-
- ☐
- Injection Well
-
- ☐
- Other _____

Was a chemical/bacteriological sample submitted to Department? Yes ☐ No ☒**5 TYPE OF BLANK CASING USED:**
☐ Steel
☒ PVC

☐ RMP (SR)
☐ ABS

☐ Wrought
☐ Asbestos-Cement

☐ Fiberglass
☐ Concrete Tile
☐ Other (Specify below) _____Blank casing diameter 2.0 in. Was casing pulled? Yes ☒ No ☐ If yes, how much 3.0 ft.Casing height above or below land surface 0.14 ft. 36 in.
PRC**6 GROUT PLUG MATERIAL:** ☐ Neat cement ☐ Cement grout ☒ Bentonite ☐ Other _____Grout Plug Intervals: From 5.44 ft. to 3.0 ft., From _____ ft. to _____ ft., From _____ ft. to _____ ft.

What is the nearest source of possible contamination:

- ☐
- Septic tank
-
- ☐
- Sewer lines
-
- ☐
- Watertight sewer lines
-
- ☐
- Lateral lines
-
- ☐
- Cess pool

- ☐
- Seepage pit
-
- ☐
- Pit privy
-
- ☐
- Sewage lagoon
-
- ☐
- Feedyard
-
- ☐
- Livestock pens

- ☒
- Fuel storage
-
- ☐
- Fertilizer storage
-
- ☐
- Insecticide storage
-
- ☐
- Abandoned water well
-
- ☐
- Oil well/Gas well

☐ Other (specify below) _____Direction from well? SW
How many feet? 110

FROM	TO	PLUGGING MATERIALS	FROM	TO	PLUGGING MATERIALS
0	3.0	Bag topsoil			
3.0	5.44	PDS Bentonite Plug, hydrated (well collapsed to this point)			

7 CONTRACTOR'S OR LANDOWNER'S CERTIFICATION: This water well was plugged under my jurisdiction and was completed on (mo/day/year) 4/15/21 and this record is true to the best of my knowledge and belief. Kansas Water Well Contractor's License No. _____. This Water Well Record was completed on (mo/day/year) 4/21/21 under the business name of Knightly Environmental Incorporated by (signature) [Signature]

Send one white copy to Kansas Department of Health & Environment, Geology Section, 1000 SW Jackson Street, Ste. 420, Topeka, KS 66612-1367. Send one copy to WATER WELL OWNER and retain one for your records.
Visit us at <http://www.kdheks.gov/waterwell/index.html> Telephone 785-296-5524.

KSA82a-1212

Revised 1/20/2015