

**WATER WELL RECORD**

**Form WWC-5**

Division of Water Resources App. No.  


Well ID

**MW7**

Original Record     Correction     Change in Well Use

**1 LOCATION OF WATER WELL:** County Johnson Fraction SW 1/4 NW 1/4 SW 1/4 SW 1/4 Section Number 32 Township Number T 12 S Range Number R 25 E  W

**2 WELL OWNER:** Last Name: First: Street or Rural Address where well is located (if unknown, distance and direction from nearest town or intersection): If at owner's address, check here:   
 Business: Kansas Department of Health and Environment  
 Address: 1000 SW Jackson, Suite 410  
 Address:  
 City: Topeka State: KS ZIP: 66612  
9401 Metcalf, Overland Park, KS 66212

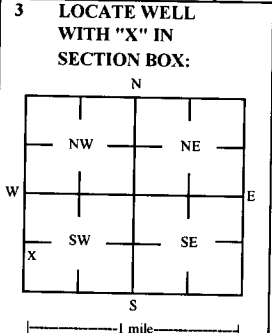

**4 DEPTH OF COMPLETED WELL:** 29.5 ft  
 Depth(s) Groundwater Encountered: 1) 15 ft  
 2) \_\_\_\_\_ ft 3) \_\_\_\_\_ ft, or 4)  Dry Well  
 WELL'S STATIC WATER LEVEL: 5.20 ft  
 below land surface, measured on (mo-day-yr) 6/23/22  
 above land surface, measured on (mo-day-yr) \_\_\_\_\_  
 Pump test data: Well water was \_\_\_\_\_ ft  
 after \_\_\_\_\_ hours pumping \_\_\_\_\_ gpm  
 Water well was \_\_\_\_\_ ft  
 after \_\_\_\_\_ hours pumping \_\_\_\_\_ gpm  
 Estimated Yield: \_\_\_\_\_ gpm  
 Bore Hole Diameter: 8.25 in to \_\_\_\_\_ ft, and  
 \_\_\_\_\_ in to \_\_\_\_\_ ft

**5 Latitude:** 38.95870 (decimal degrees)  
**Longitude** -94.66728 (decimal degrees)  
 Horizontal Datum  WGS 84  NAD 83  NAD 27  
 Source for Latitude/Longitude:  
 GPS (unit make/model: \_\_\_\_\_)  
 (WAAS enabled?  Yes  No)  
 Land Survey  Topographic Map  
 Online Mapper

**6 Elevation** 950.87 ft  Ground Level  TOC  
 Source  Land Survey  GPS  Topographic Map  
 Other \_\_\_\_\_

**7 WELL WATER TO BE USED AS:**

1 Domestic:  Household  Lawn & Garden  Livestock  Irrigation  Feedlot  Industrial

2  Public Water Supply: well ID \_\_\_\_\_  
 3  Dewatering: how many wells? \_\_\_\_\_  
 4  Aquifer Recharge: well ID \_\_\_\_\_  
 5  Monitoring: well ID MW7  
 6 Environmental Remediation: well ID \_\_\_\_\_  
 7 Air Sparge  Soil Vapor Extraction  Recovery  Injection

8  Oil Field Water Supply: lease \_\_\_\_\_  
 9 Test Hole: well ID \_\_\_\_\_  
 Cased  Uncased  Geotechnical  
 10 Geothermal: How many bores?  
 a) Closed Loop  Horizontal  Vertical  
 b) Open Loop  Surface Discharge  Inj. of Water  
 Other (specify): \_\_\_\_\_

Was a chemical/bacteriological sample submitted to KDHE?  Yes  No If yes, date sample was submitted: \_\_\_\_\_  
 Water well disinfected?  Yes  No

**8 TYPE OF CASING USED:**  Steel  PVC  Other \_\_\_\_\_ CASING JOINTS:  Glued  Clamped  Welded  Threaded  
 Casing diameter 2 in. to 19.5 ft, Diameter \_\_\_\_\_ in. to \_\_\_\_\_ ft, Diameter \_\_\_\_\_ in. to \_\_\_\_\_ ft,  
 Casing height above land surface -0.32 in. Weight \_\_\_\_\_ lbs./ft. Well thickness or gauge No \_\_\_\_\_  
**TYPE OF SCREEN OR PERFORATION MATERIAL:**  
 Steel  Stainless Steel  Fiberglass  PVC  Other (Specify) \_\_\_\_\_  
 Brass  Galvanized Steel  Concrete tile  None used (open hole)  
**SCREEN OR PERFORATION OPENINGS ARE:**  
 Continuous Slot  Mill Slot  Gauze Wrapped  Torch Cut  Drilled Holes  Other (Specify) \_\_\_\_\_  
 Louvered Shutter  Key Punched  Wire Wrapped  Saw Cut  None (Open Hole)  
**SCREEN-PERFORATED INTERVALS:** From 19.5 ft. to 29.5 ft, From \_\_\_\_\_ ft. to \_\_\_\_\_ ft, From \_\_\_\_\_ ft. to \_\_\_\_\_ ft,  
**GRAVEL PACK INTERVALS:** From 17.5 ft. to 29.5 ft, From \_\_\_\_\_ ft. to \_\_\_\_\_ ft, From \_\_\_\_\_ ft. to \_\_\_\_\_ ft,

**9 GROUT MATERIAL:**  Neat cement  Cement grout  Bentonite  Other Concrete: 0-0.5'  
 Grout intervals: From 0.5 ft. to 17.5 ft, From \_\_\_\_\_ ft. to \_\_\_\_\_ ft, From \_\_\_\_\_ ft. to \_\_\_\_\_ ft,

**Nearest source of possible contamination:**  
 Septic Tank  Lateral Lines  Pit Privy  Livestock Pens  Insecticide Storage  
 Sewer Lines  Cess Pool  Sewage Lagoon  Fuel Storage  Abandoned Water Well  
 Watertight Sewer Lines  Seepage Pit  Feedyard  Fertilizer Storage  Oil Well / Gas Well  
 Other (Specify) \_\_\_\_\_  
 Direction from well? N Distance from well? 300 ft

10 FROM	TO	LITHOLOGIC LOG	FROM	TO	LITHO. LOG (cont.) or PLUGGING INTERVALS
0	0.5	Dark brown top soil			
0.5	0.8	Light brown w. rock fill			
0.8	7	Tan brown clay			
7	8	Dark brown clay			
8	27	Reddish brown clay			
27	29.5	Blue shale			

Notes: KDHE ID: **French Market Dry Cleaning; C4-046-73624**  
 Target of monitoring well is shallow groundwater, <20' of grout was installed at the direction of KDHE.

**11 CONTRACTOR'S OR LANDOWNER'S CERTIFICATION:** This water well was  constructed,  reconstructed, or  plugged under my jurisdiction and was completed on (mo-day-year) 6/16/22 and this record is true to the best of my knowledge and belief. Kansas Water Well Contractor's License No. 757 This Water Well Record was completed on (mo-day-year) 7/26/22 under the business name of Larsen & Associates, Inc. Signature \_\_\_\_\_

Mail 1 white copy along with a fee of \$5.00 for each constructed well to: Kansas Department of Health and Environment, Bureau of Water Resources Section, 1000 SW Jackson St., Suite 420, Topeka, Kansas 66612-1367. Mail one to Water Well Owner and retain one for your records. Telephone 785-296-5524.  
 Visit us at <http://www.kdheks.gov/waterwell/index.html> KSA 82a-1212 Revised 7/10/2015