

NOTE: Figures exhibited within this report are only to be used within the context of this report. Placement of property lines, wells, structures, and roads is based on the available information from county appraiser maps, surveys, site visits, and/or previous vendor reports and should be considered approximate. Estimated concentration lines represent estimated contaminant concentrations based on data collected during the sampling event. Actual extent or concentration of contamination beyond the sample point is unknown.

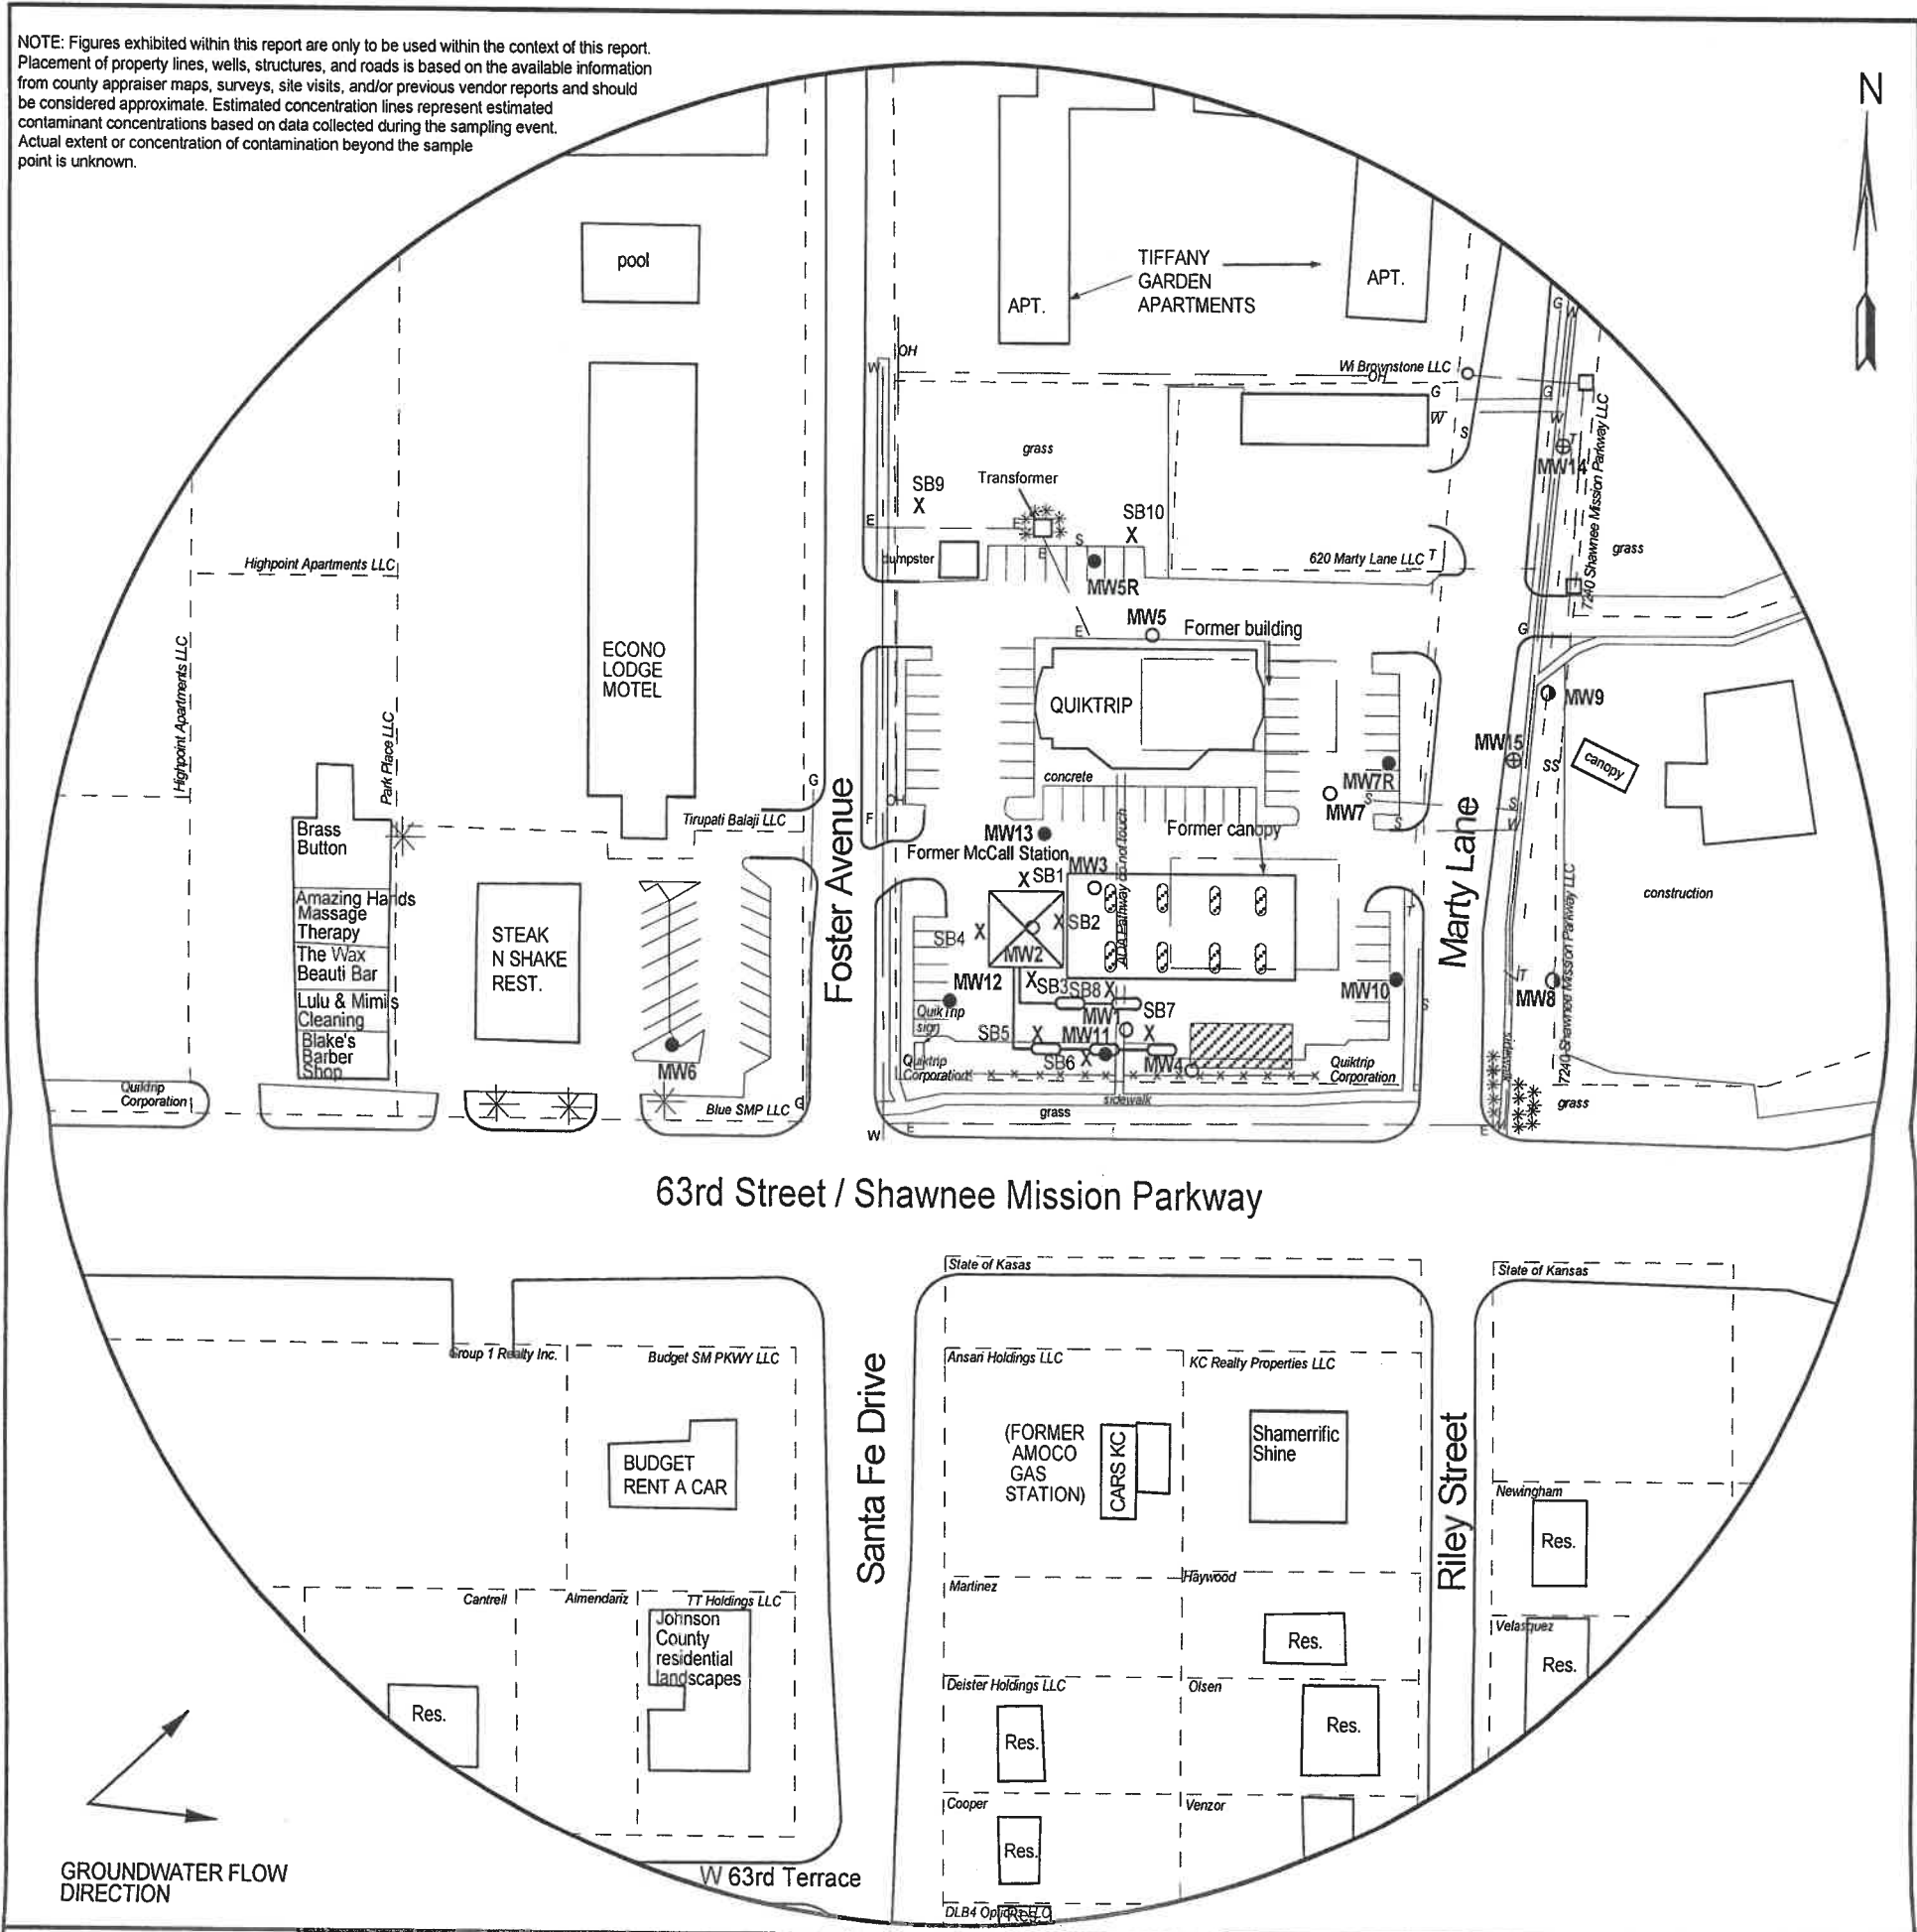


FIGURE 2.2 - 500 FT RADIUS AREA BASE MAP



1311 E. 25th St., Suite B (785) 841-8707
Lawrence, KS 66046 (785) 865-4282

PROJECT:

McCall Service Station # 21
7414 W. 63rd Street
Overland Park, KS
KDHE ID: U4-046-01596
Date: 9/1/22

0 100 FT
SCALE

LEGEND:

- Former Pump Island/Product Line
- Former UST
- Active UST Basin and Pump Islands
- Approximate Location of Property Line
- Existing Monitoring Well
- Plugged Monitoring Well
- Destroyed Monitoring Well
- New Monitoring Well (Installed 8/30/22)
- Soil Boring (Drilled 8/29-30/22)
- Gas Lines 1.5-3 ft bgs
- Water Lines (2-6 ft bgs)
- Overhead Lines (25-40 ft high)
- Electric Lines (2-6 ft bgs)
- Telephone Lines (2-6 ft bgs)
- Sewer Lines (2-6 ft bgs)

NOTE: SB9 & SB10 were drilled to collect hydrologic samples.

Shawnee

7-12-25E

DENNIS L HANDKE

1820 NW 59th Terrace
TOPEKA, KANSAS 66618
785-286-4047 Home

Jess Chapman
Larsen & Associates
1311 E. 25th Street, Suite B
Lawrence, Kansas, 66046

September 17, 2022

RE: Monitor Well Elevation Survey
7414 W. 63rd St., Overland Park, Kansas

Proj. 22-00ZZ
McCall Service Station #21
KDHE ID U4-046-01596


Bench Mark: Chisled Sq. on NW corner of concrete storm inlet near SE corner of property.
Elev: 1042.06 North 161 West 971 (from SE Cor. Sec.7-12-25E)

MW-14	rim	1034.82	North	458	NE1/4, SW1/4, SE1/4, SE1/4
	top pipe	1034.25	West	883	Lat= 39.01607 Long = 94.67089
MW-15	rim	1038.05	North	287	SE1/4, SW1/4, SE1/4, SE1/4
	top pipe	1037.72	West	916	Lat= 39.01560 Long = 94.67100

Elevation derived from existing project. NAVD 88

Lat & Long derived from Shawnee 7.5 Quad Map NAVD 29

If you have any questions, please feel free to call me. Thank you for the opportunity to be of service to you.

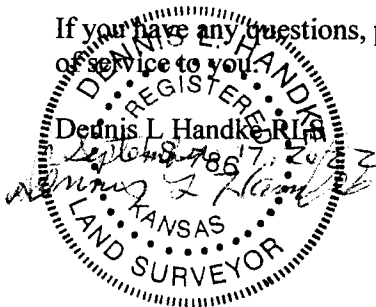

RECEIVED
OCT 04 2022
BUREAU OF WATER