

NAME OF WATER WELL:

Fraction

Section Number

Township Number

Range Number

Johnson

NW 1/4 SW 1/4 SW 1/4

15

T 12 S

R 25 EW

Location and direction from nearest town or city street address of well if located within city?


6901 Mission Road, Prairie Village, Kansas

2 WATER WELL OWNER: Anoco Oil Company
 HHP, St. Address, Box #: 8700 INDIAN CREEK PKWY, Bldg. 3, Suite 190
 City, State, ZIP Code: Overland Park, Kansas 66210

Board of Agriculture, Division of Water Resources
 Application Number:

3 LOCATE WELL'S LOCATION WITH AN "X" IN SECTION BOX:

4 DEPTH OF COMPLETED WELL: 13.5 ft. ELEVATION: 908.74

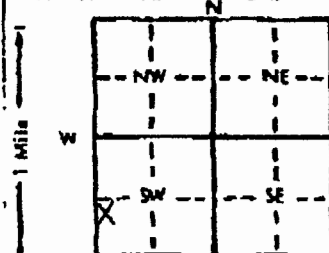

Depth(s) Groundwater Encountered 1. 8.78 ft. 2. ft. 3. ft.
 WELL'S STATIC WATER LEVEL 8.78 ft. below land surface measured on m/d/y/r 5/26/94

Pump test data: Well water was ft. after hours pumping gpm
 Est. Yield gpm Well water was ft. after hours pumping gpm

Bore Hole Diameter: 6 in. to ft. and in. to ft.

WELL WATER TO BE USED AS: 5 Public water supply 8 Air conditioning 11 Injection well

1 Domestic 3 Foodlot 6 Oil field water supply 9 Dewatering 12 Other (Specify below)

2 Irrigation 4 Industrial 7 Lawn and garden only 10 Monitoring well 13 Other (Specify below)

Was a chemical/bacteriological sample submitted to Department? Yes No If yes, m/d/y/r sample was submitted

Water Well Disinfected? Yes No

5 TYPE OF BLANK CASING USED:

5 Wrought iron 8 Concrete tile CASING JOINTS: Glued Clamped

1 Steel 3 RMP (SRP)

6 Asbestos-Cement 9 Other (specify below) Welded

2 PVC 4 ABS

7 Fiberglass Threaded

Blank casing diameter 2 in. to ft. Dia. in. to ft. Dia. in. to ft. Dia.

Casing height above land surface 0.3 in. weight lbs./ft. Wall thickness or gauge No.

TYPE OF SCREEN OR PERFORATION MATERIAL:

7 PVC 10 Asbestos-cement

1 Steel 3 Stainless steel 5 Fiberglass 8 RMP (SRP) 11 Other (specify)

2 Brass 4 Galvanized steel 6 Concrete tile 9 ASS 12 None used (open hole)

SCREEN OR PERFORATION OPENINGS ARE:

5 Gauzed wrapped 8 Saw cut 11 None (open hole)

1 Continuous slot 3 Well slot 6 Wire wrapped 9 Drilled holes

2 Louvered shutter 4 Key punched 7 Torch cut 10 Other (specify)

SCREEN-PERFORATED INTERVALS:

From 3.5 ft. to 13.5 ft. From ft. to ft. From ft. to ft. From ft. to ft.

GRAVEL PACK INTERVALS:

From 1.5 ft. to 13.5 ft. From ft. to ft. From ft. to ft. From ft. to ft.

FROM TO LITHOLOGIC LOG FROM TO PLUGGING INTERVALS

FROM TO LITHOLOGIC LOG FROM TO PLUGGING INTERVALS

CONTRACTOR'S OR LANDOWNER'S CERTIFICATION: This water well was (1) constructed, (2) reconstructed, or (3) plugged under my jurisdiction and was completed on (m/d/y/r) 5/05/94 and this record is true to the best of my knowledge and belief. Kansas

Water Well Contractor's License No. 5334 This Water Well Record was completed on (m/d/y/r) 5/26/94 by (signature) J. C. Durm

Under the business name of Professional Service, Inc. by (signature) J. C. Durm

INSTRUCTIONS: Use typewriter or ball point pen. PLEASE PRINT FULLY and clearly. Please fill in blanks, underline or circle the correct answers. Send trip three copies to Kansas Department of Health and Environment, Bureau of Water, Topeka, Kansas 66603-0001. Telephone: 813-296-5545. Send one to WATER WELL OWNER and retain one for your records.