


1 LOCATION OF WATER WELL: County: <u>Johnson</u>	Fraction <u>NE 1/4 SW 1/4 SW 1/4</u>	Section Number <u>26</u>	Township Number T <u>12</u> S	Range Number R <u>25</u> E/N
---	---	-----------------------------	----------------------------------	---------------------------------

Distance and direction from nearest town or city street address of well if located within city?

2. WATER WELL OWNER: *Amoco Oil Company* STATION # *2384*
RR#, St. Address, Box #: *8700 Indian Creek Parkway, Bldg #3 Suite 190* Board of Agriculture, Division of Water Resources
City, State, ZIP Code: *Overland Park, Ks. 66210* MW-29 Application Number:

3 LOCATE WELL'S LOCATION WITH AN "X" IN SECTION BOX: 4 DEPTH OF COMPLETED WELL: 15.97 ft. ELEVATION: Relative ELU.

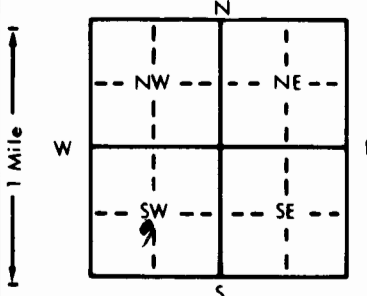

4 DEPTH OF COMPLETED WELL: 15.97 ft. ELEVATION: Relative ELU.

Depth(s) Groundwater Encountered 1. _____ ft. 2. _____ ft. 3. _____ ft.

WELL'S STATIC WATER LEVEL 6.08 ft. below land surface measured on mo/day/yr 9-12-94

Pump test data: Well water was _____ ft. after _____ hours pumping _____ gpm

Est. Yield _____ gpm: Well water was _____ ft. after _____ hours pumping _____ gpm

Bore Hole Diameter. 7.78 in. to 17.0 ft., and _____ in. to _____ ft.

WELL WATER TO BE USED AS:

1 Domestic	3 Feedlot	6 Oil field water supply	8 Air conditioning	11 Injection well
2 Irrigation	4 Industrial	7 Lawn and garden only	9 Dewatering	12 Other (Specify below)
			10 Monitoring well	

Was a chemical/bacteriological sample submitted to Department? Yes _____ No _____; If yes, mo/day/yr sample was submitted _____

Water Well Disinfected? Yes _____ No _____

5 TYPE OF BLANK CASING USED:		3 Wrought iron	8 Concrete tile	CASING JOINTS: Glued		Clamped
1 Steel	3 RMP (SR)	6 Asbestos-Cement	9 Other (specify below)	Welded		
(2 PVC)	4 ABS	7 Fiberglass		Threaded		
Blank casing diameter 2 . . . in. to 5.90 . . . ft., Dia		. . . in. to . . . ft., Dia		. . . in. to . . . ft., Dia		
Casing above land surface. 0 . . . in., weight		. . . lbs./ft. Wall thickness or gauge No.				
TYPE OF SCREEN OR PERFORATION MATERIAL:				7 PVC	10 Asbestos-cement	
1 Steel	3 Stainless steel	5 Fiberglass	8 RMP (SR)	11 Other (specify)		
2 Brass	4 Galvanized steel	6 Concrete tile	9 ABS	12 None used (open hole)		
SCREEN OR PERFORATION OPENINGS ARE:				8 Saw cut	11 None (open hole)	
1 Continuous slot	(3 Mill slot) 0.010"	5 Gauzed wrapped	9 Drilled holes			
2 Louvered shutter	4 Key punched	7 Torch cut	10 Other (specify)			
SCREEN-PERFORATED INTERVALS:		From . . . 5.90 . . . ft. to . . . 15.30 . . . ft., From ft. to ft.				
		From ft. to ft., From ft. to ft.				
GRAVEL PACK INTERVALS:		From . . . 4.47 . . . ft. to . . . 17.0 . . . ft., From ft. to ft.				
		From ft. to ft., From ft. to ft.				

6 GROUT MATERIAL: 1 Neat cement 2 Cement grout 3 Bentonite 4 Other
Grout Intervals: From 0 ft. to 1.0 ft., From 1.0 ft. to 4.47 ft., From ft. to ft.
What is the nearest source of possible contamination:
1 Septic tank 4 Lateral lines 7 Pit privy 11 Fuel storage 14 Abandoned water well
2 Sewer lines 5 Cess pool 8 Sewage lagoon 12 Fertilizer storage 15 Oil well/Gas well
3 Watertight sewer lines 6 Seepage pit 9 Feedyard 13 Insecticide storage 16 Other (specify below)
Direction from well? How many feet?

[illegible]

7 CONTRACTOR'S OR LANDOWNER'S CERTIFICATION: This water well was (1) constructed, (2) reconstructed, or (3) plugged under my jurisdiction and was completed on (mo/day/year) 7-15-94 and this record is true to the best of my knowledge and belief. Kansas Water Well Contractor's License No. 483 This Water Well Record was completed on (mo/day/yr) 3-13-95 under the business name of T.E.S.T. by (signature) Paul J. Robin