

CORRECTION(S) TO WATER WELL RECORD (WWC-5)

(to rectify lacking or incorrect information)

County: Johnson

Location listed as:

Section-Township-Range: 30-125-25EFraction ($\frac{1}{4}$ $\frac{1}{4}$ $\frac{1}{4}$): SE SE SE

Location changed to:

30-125-25ESW SW NEOther changes: Initial statements: Wyandotte CountyChanged to: Johnson County

Comments:

verification method: Well address, city street map, Legal description,
and Lenexa 1:24,000 topo. map.initials: DR date: 10/7/2005

submitted by: Kansas Geological Survey, Data Resources Library, 1930 Constant Ave., Lawrence, KS 66047-3726

to: Kansas Dept of Health & Environment, Bureau of Water, 1000 SW Jackson, Suite 420, Topeka, KS 66612-1367.

1 LOCATION OF WATER WELL: County: **WYANDOTTE** Fraction: **SE 1/4 SE 1/4 SE 1/4** Section Number: **30** Township Number: **T 12 S** Range Number: **R 25 E**

Distance and direction from nearest town or city street address of well if located within city?

8205 SANTE FE DR. OVERLAND PARK, KS

2 WATER WELL OWNER: **TOWN + COUNTRY MARKET**


RR#, St. Address, Box #: **P.O. Box 17087**

City, State, ZIP Code: **WICHITA, KS**

Board of Agriculture, Division of Water Resources

Application Number:

3 LOCATE WELL'S LOCATION WITH AN "X" IN SECTION BOX:

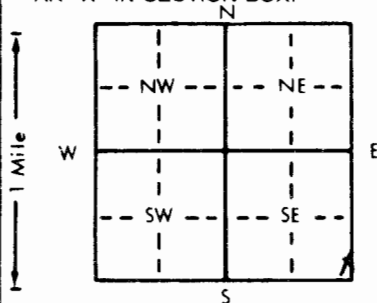

4 DEPTH OF COMPLETED WELL: **13.1** ft. ELEVATION:

Depth(s) Groundwater Encountered: **13.0** ft. 2. ft. 3. ft.

WELL'S STATIC WATER LEVEL: **13.0** ft. below land surface measured on mo/day/yr: **4-10-95**

Pump test data: Well water was _____ ft. after _____ hours pumping _____ gpm

Est. Yield _____ gpm: Well water was _____ ft. after _____ hours pumping _____ gpm

Bore Hole Diameter: **8.25** in. to **13.1** ft. and _____ in. to _____ ft.

WELL WATER TO BE USED AS: 5 Public water supply 8 Air conditioning 11 Injection well

1 Domestic 3 Feedlot 6 Oil field water supply 9 Dewatering 12 Other (Specify below)

2 Irrigation 4 Industrial 7 Lawn and garden only ☒ 10 Monitoring well

Was a chemical/bacteriological sample submitted to Department? Yes _____ No ☒ If yes, mo/day/yr sample was sub-

mitted _____ Water Well Disinfected? Yes _____ No ☒

5 TYPE OF BLANK CASING USED:

1 Steel 3 RMP (SR)

☒ 2 PVC 4 ABS

Blank casing diameter: **2.0** in. to **8.1** ft. Dia _____ in. to _____ ft. Dia _____ in. to _____ ft.

Casing height above land surface: **-1.0** in. weight _____ lbs./ft. Wall thickness or gauge No. _____

TYPE OF SCREEN OR PERFORATION MATERIAL:

1 Steel 3 Stainless steel

2 Brass 4 Galvanized steel

5 Fiberglass

6 Concrete tile

☒ 7 PVC

8 RMP (SR)

9 ABS

10 Asbestos-cement

11 Other (specify) _____

12 None used (open hole)

SCREEN OR PERFORATION OPENINGS ARE:

1 Continuous slot

2 Louvered shutter

☒ 3 Mill slot **0.010**

4 Key punched

5 Gauzed wrapped

6 Wire wrapped

7 Torch cut

8 Saw cut

9 Drilled holes

10 Other (specify) _____

11 None (open hole)

SCREEN-PERFORATED INTERVALS: From **8.1** ft. to **13.1** ft. From _____ ft. to _____ ft.

From _____ ft. to _____ ft. From _____ ft. to _____ ft.

GRAVEL PACK INTERVALS: From **7.0** ft. to **13.1** ft. From _____ ft. to _____ ft.

From _____ ft. to _____ ft. From _____ ft. to _____ ft.

6 GROUT MATERIAL: 1 Neat cement 2 Cement grout ☒ 3 Bentonite ☒ 4 Other **CONCRETE 0.0 - 1.0**

Grout Intervals: From **1.0** ft. to **7.0** ft. From _____ ft. to _____ ft. From _____ ft. to _____ ft.

What is the nearest source of possible contamination:

1 Septic tank

4 Lateral lines

7 Pit privy

10 Livestock pens

14 Abandoned water well

2 Sewer lines

5 Cess pool

8 Sewage lagoon

☒ 11 Fuel storage

15 Oil well/Gas well

3 Watertight sewer lines 6 Seepage pit

9 Feedyard

12 Fertilizer storage

16 Other (specify below)

13 Insecticide storage

Direction from well?

How many feet? **10**

FROM	TO	LITHOLOGIC LOG	FROM	TO	PLUGGING INTERVALS
0.0	0.5	CONCRETE			
0.5	3.0	BLK CLAY			
3.0	10.0	GRN/BRN CLAY			
10.0	13.1	BRN CLAY			
13.1		LS			

7 CONTRACTOR'S OR LANDOWNER'S CERTIFICATION: This water well was ☒ (1) constructed, (2) reconstructed, or (3) plugged under my jurisdiction and was completed on (mo/day/year) **4-10-95** and this record is true to the best of my knowledge and belief. Kansas

Water Well Contractor's License No. **416** This Water Well Record was completed on (mo/day/yr) **5-27-95**

under the business name of **TERRACON CONSULTANTS INC** by (signature) **Thomas J. ...**