


1 LOCATION OF WATER WELL: County: Dickinson Fraction: NE 1/4 NE 1/4 NE 1/4 Section Number: 7 Township Number: T 12 S Range Number: R 3 EW

Distance and direction from nearest town or city street address of well if located within city? From Abilene Go 7 miles North on 15 Highway To 18 Then Go 3 miles East on 18

2 WATER WELL OWNER: Mr. + Mrs. Herb Graves
 RR#, St. Address, Box #: P.O. Box 452 Board of Agriculture, Division of Water Resources
 City, State, ZIP Code: Chapman, Kansas 67431 Application Number:

3 LOCATE WELL'S LOCATION WITH AN "X" IN SECTION BOX:

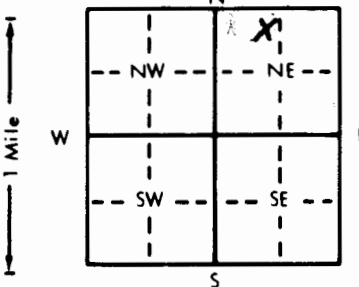

4 DEPTH OF COMPLETED WELL: 140' ft. ELEVATION: ft.
 Depth(s) Groundwater Encountered: 1. 106' ft. 2. ft. 3. ft.
 WELL'S STATIC WATER LEVEL: 90' ft. below land surface measured on mo/day/yr
 Pump test data: Well water was ft. after hours pumping gpm
 Est. Yield: 40 gpm; Well water was ft. after hours pumping gpm
 Bore Hole Diameter: 8" in. to 140' ft., and in. to ft.
 WELL WATER TO BE USED AS:
 1 Domestic 3 Feedlot 6 Oil field water supply 9 Dewatering 12 Other (Specify below)
 2 Irrigation 4 Industrial 7 Lawn and garden only 10 Monitoring well
 Was a chemical/bacteriological sample submitted to Department? Yes.....No.....; If yes, mo/day/yr sample was submitted
 Water Well Disinfected? Yes No

5 TYPE OF CASING USED:
 1 Steel 3 RMP (SR) 5 Wrought iron 8 Concrete tile CASING JOINTS: Glued Clamped
 2 PVC 4 ABS 6 Asbestos-Cement 9 Other (specify below) Welded SCHEDULE
 7 Fiberglass Threaded.....

Blank casing diameter: 5" in. to 120' ft., Dia. in. to ft., Dia. in. to ft.
 Casing height above land surface: 2' in., weight 54.40 lbs./ft. Wall thickness or gauge No.

TYPE OF SCREEN OR PERFORATION MATERIAL:
 1 Steel 3 Stainless steel 5 Fiberglass 7 PVC 10 Asbestos-cement
 2 Brass 4 Galvanized steel 6 Concrete tile 9 ABS 11 Other (specify)
 12 None used (open hole)

SCREEN OR PERFORATION OPENINGS ARE:
 1 Continuous slot 3 Mill slot 3/3000's 5 Gauzed wrapped 8 Saw cut 11 None (open hole)
 2 Louvered shutter 4 Key punched 6 Wire wrapped 9 Drilled holes
 7 Torch cut 10 Other (specify)

SCREEN-PERFORATED INTERVALS: From 120' ft. to 140' ft., From ft. to ft.
 From ft. to ft., From ft. to ft.
 GRAVEL PACK INTERVALS: From 25 ft. to 140 ft., From ft. to ft.
 From ft. to ft., From ft. to ft.

6 GROUT MATERIAL: 1 Neat cement 2 Cement grout 3 Bentonite 4 Other
 Grout intervals: From 0 ft. to 25 ft., From ft. to ft., From ft. to ft.

What is the nearest source of possible contamination:
 1 Septic tank 4 Lateral lines 7 Pit privy 10 Livestock pens 14 Abandoned water well
 2 Sewer lines 5 Cess pool 8 Sewage lagoon 11 Fuel storage 15 Oil well/Gas well
 3 Watertight sewer lines 6 Seepage pit 9 Feedyard 12 Fertilizer storage 16 Other (specify below)
 13 Insecticide storage
 Direction from well? South West How many feet? 120'

FROM	TO	LITHOLOGIC LOG	FROM	TO	PLUGGING INTERVALS
0	17	Brown clay	135	140	Shale
17	18	Rock			
18	25	Greenish shale			
25	45	Brown shale			
45	54	Rock			
54	65	Shale			
65	69	Rock			
69	74	Shale			
74	76	Rock			
76	87	Shale			
87	88	Rock			
88	106	Shale			
106	127	Rock (water)			
127	130	Shale			
130	135	Rock			

I was Drilling Blind, couldn't tell what colors I was in from 54' down

7 CONTRACTOR'S OR LANDOWNER'S CERTIFICATION: This water well was (1) constructed, (2) reconstructed, or (3) plugged under my jurisdiction and was completed on (mo/day/year) 6/30/88 and this record is true to the best of my knowledge and belief. Kansas Water Well Contractor's License No. 451 This Water Well Record was completed on (mo/day/yr) 7/26/88 under the business name of Holdeman Well Drilling by signature Craig Holt CWD/PE