USE TYPEWRITER OR BALL POINT PEN-PRESS FIRMLY, PRINT CLEARLY.

WATER WELL RECORD
KSA 82a-1201-1215

Kansas Department of Health and Environment-Division of Environment
(Water well Contractors)
Topeka, Kansas 66620

1. Location of well:	County: Dickinson	Fraction: SE 1/4 SE 1/4 NE 1/4	Section number: 26	Township number: T 12 S	Range number: R 3 E

2. Distance and direction from nearest town or city: 2 west 1 3/4
Street address of well location if in city: North Chapman

3. Owner of well: Kenneth Woods
R.R. or street: R.2
City, state, zip code: Chapman, Ks 67431

4. Locate with "X" in section below:

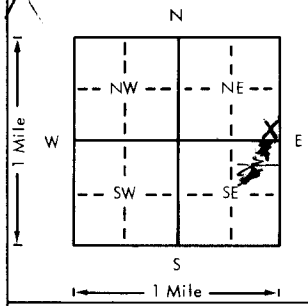

Sketch map:

6. Bore hole dia. 8 in. Completion date 8-17-79
Well depth 107 ft.

7. __ Cable tool X Rotary __ Driven __ Dug
__ Hollow rod __ Jetted __ Bored __ Reverse rotary

8. Use: X Domestic __ Public supply __ Industry
__ Irrigation __ Air conditioning __ Stock
__ Lawn __ Oil field water __ Other

9. Casing: Material Pvc. Height: Above or below
Threaded ___ Welded ___ Surface 12 in.
RMP ___ PVC ___ Weight 200 lbs./ft.
Dia. 5 in. to 107 ft. depth Wall Thickness: inches or
Dia. ___ in. to ___ ft. depth gage No. 200

10. Screen: Manufacturer's name Plastic NSF approved
Type Plastic Dia. 5
Slot/gouze .060 Length 20
Set between 52 ft. and 62 ft.
97 ft. and 107 ft.
Gravel pack? yes Size range of material 3/8-3/4

11. Static water level: mo./day/yr.
40 ft. below land surface Date 8-17-79

12. Pumping level below land surfaces:
___ ft. after ___ hrs. pumping ___ g.p.m.
___ ft. after ___ hrs. pumping ___ g.p.m.
Estimated maximum yield 40 g.p.m.

13. Water sample submitted: mo./day/yr.
__ Yes X No Date

14. Well head completion: capped
__ Pitless adapter ___ Inches above grade

15. Well grouted? yes
With: __ Neat cement __ Bentonite X Concrete
Depth: From 0 ft. to 20 ft.

16. Nearest source of possible contamination:
ft. 75 Direction South Type septic tank
Well disinfected upon completion? X Yes __ No

17. Pump: X Not installed
Manufacturer's name
Model number ___ HP ___ Volts ___
Length of drop pipe ___ ft. capacity ___ g.p.m.
Type:
__ Submersible __ Turbine
__ Jet __ Reciprocating
__ Centrifugal __ Other

5. Type and color of material	From	To
shale yellow	0	6
Shale Gray	6	10
shale Brown	10	23
shale Tan + White	23	32
shaley Limestone	32	40
Limestone	40	45
shale yellow	45	56
Rock flint	56	57
Limestone	57	59
shale yellow	59	61
shale Blue	61	63
shale yellow + Brown	63	76
shale Brown	76	95
~~shale~~ Red + Brown	95	97
Limestone	97	107

(Use a second sheet if needed)

18. Elevation:

Topography:
__ Hill
X Slope
__ Upland
__ Valley

19. Remarks:

20. Water well contractor's certification:
This well was drilled under my jurisdiction and this report is true to the best of my knowledge and belief.
Blue Valley Drilling 234D
Business name License No.
Address Blue Rapids Ks. 66411
Signed Gerald Staler Date 9-11-79
Authorized representative

T 12 R 3 W Sec 26 1/4 SE 1/4 SE 1/4

Forward the white, blue and pink copies to the Department of Health and Environment

Form WWC-5

MI-1023