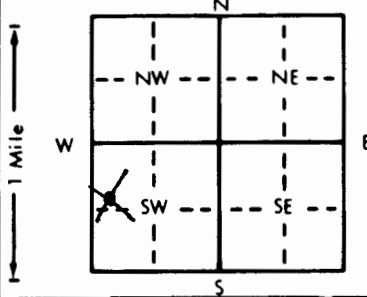


1 LOCATION OF WATER WELL: Fraction Section Number Township Number Range Number
 County: Dickinson SW 1/4 NW 1/4 SW 1/4 28 T 12 S R 3 E

Distance and direction from nearest town or city street address of well if located within city?
 3 miles North & 1/2 Mile East of Detroit, KS

2 WATER WELL OWNER: H.G. Turner
 RR#, St. Address, Box #: Rt 5
 City, State, ZIP Code: Abilene, KS 67410
 Board of Agriculture, Division of Water Resources
 Application Number:

3 LOCATE WELL'S LOCATION WITH AN "X" IN SECTION BOX:

 4 DEPTH OF COMPLETED WELL: 86 ft. ELEVATION:
 Depth(s) Groundwater Encountered 1. 43 ft. 2. ft. 3. ft.
 WELL'S STATIC WATER LEVEL: 43 ft. below land surface measured on mo/day/yr 11-29 & 30-93
 Pump test data: Well water was ft. after hours pumping gpm
 Est. Yield 10-20 gpm: Well water was ft. after hours pumping gpm
 Bore Hole Diameter: 9 in. to 87 ft. and in. to ft.
 WELL WATER TO BE USED AS:
 5 Public water supply 8 Air conditioning 11 Injection well
 1 Domestic 3 Feedlot 6 Oil field water supply 9 Dewatering 12 Other (Specify below)
 2 Irrigation 4 Industrial 7 Lawn and garden only 10 Monitoring well Heat Pump Discharge
 Was a chemical/bacteriological sample submitted to Department? Yes No X; If yes, mo/day/yr sample was submitted
 Water Well Disinfected? Yes X No

5 TYPE OF BLANK CASING USED:
 1 Steel 3 RMP (SR) 5 Wrought iron 8 Concrete tile CASING JOINTS: Glued X Clamped
 2 PVC 4 ABS 6 Asbestos-Cement 9 Other (specify below) Welded
 7 Fiberglass Threaded
 Blank casing diameter 5 in. to 76 ft. Dia in. to ft. Dia in. to ft.
 Casing height above land surface 12 in., weight 2.37 lbs./ft. Wall thickness or gauge No. 2.14

TYPE OF SCREEN OR PERFORATION MATERIAL:
 1 Steel 3 Stainless steel 5 Fiberglass 7 PVC 10 Asbestos-cement
 2 Brass 4 Galvanized steel 6 Concrete tile 8 RMP (SR) 11 Other (specify)
 9 ABS 12 None used (open hole)

SCREEN OR PERFORATION OPENINGS ARE:
 1 Continuous slot 3 Mill slot 5 Gauzed wrapped 8 Saw cut 11 None (open hole)
 2 Louvered shutter 4 Key punched 6 Wire wrapped 9 Drilled holes
 7 Torch cut 10 Other (specify)

SCREEN-PERFORATED INTERVALS: From 76 ft. to 86 ft., From ft. to ft.
 From ft. to ft., From ft. to ft.
 GRAVEL PACK INTERVALS: From 25 ft. to 86 ft., From ft. to ft.
 From ft. to ft., From ft. to ft.

6 GROUT MATERIAL: 1 Neat cement 2 Cement grout 3 Bentonite 4 Other
 Grout intervals: From 5 ft. to 25 ft., From ft. to ft., From ft. to ft.

What is the nearest source of possible contamination:
 1 Septic tank 4 Lateral lines 7 Pit privy 10 Livestock pens 14 Abandoned water well
 2 Sewer lines 5 Cess pool 8 Sewage lagoon 11 Fuel storage 15 Oil well/Gas well
 3 Watertight sewer lines 6 Seepage pit 9 Feedyard 12 Fertilizer storage 16 Other (specify below)
 13 Insecticide storage

Direction from well? Southwest How many feet? 75ft

| FROM | TO | LITHOLOGIC LOG | FROM | TO | PLUGGING INTERVALS |
|--------|--------|-----------------------------|------|----|--------------------|
| 0 | 4 | Top Soil | | | |
| 4 | 6 | Tan Clay | | | |
| 6 | 7 | Rock | | | |
| 7 | 11 | Tan Clays | | | |
| 11 | 14 | Green Shale | | | |
| 14 | 42 | Red & Gray Shale Layers | | | |
| 42 | 52 | Limestone & Shale Layers | | | |
| 52 | 59 | Gray Shale | | | |
| 59 | 63 | Limestone | | | |
| 63 | 79 | Layers of Shale & Limestone | | | |
| 79 | 81 | Limestone | | | |
| 81 | 81 1/2 | Small Cavity | | | |
| 81 1/2 | 87 | Limestone | | | |

7 CONTRACTOR'S OR LANDOWNER'S CERTIFICATION: This water well was (1) constructed, (2) reconstructed, or (3) plugged under my jurisdiction and was completed on (mo/day/year) 11-30-93 and this record is true to the best of my knowledge and belief. Kansas Water Well Contractor's License No. 138. This Water Well Record was completed on (mo/day/yr) 12-2-93 under the business name of Peterson Irrigation Inc. by (signature) Mike Peters

OFFICE USE ONLY
T
R
EW
SEC.