


1 LOCATION OF WATER WELL: Fraction NW 1/4 NE 1/4 SW 1/4 Section Number 8 Township Number T 12 S Range Number R 3 E
 County: Dickinson

Distance and direction from nearest town or city street address of well if located within city?
at Detroit (no St. Address)

2 WATER WELL OWNER: Larry Womichte
 RR#, St. Address, Box #: Rt 5
 City, State, ZIP Code: Enterprise
 Board of Agriculture, Division of Water Resources
 Application Number:

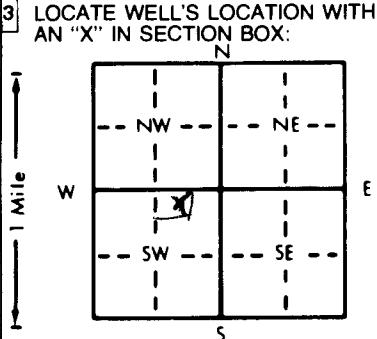

4 DEPTH OF COMPLETED WELL: 60 ft. ELEVATION: ft.
 Depth(s) Groundwater Encountered 1. 29 ft. 2. ft. 3. ft.
 WELL'S STATIC WATER LEVEL: 31 ft. below land surface measured on mo/day/yr Aug 3 96
 Pump test data: Well water was ft. after hours pumping gpm
 Est. Yield 267 gpm Well water was ft. after hours pumping gpm
 Bore Hole Diameter: 9 in. to 24 in. and 6 7/8 in. to 60 in.
 WELL WATER TO BE USED AS:
 1 Domestic 2 Irrigation 3 Feedlot 4 Industrial
 5 Public water supply 6 Oil field water supply 7 Lawn and garden only
 8 Air conditioning 9 Dewatering 10 Monitoring well
 11 Injection well 12 Other (Specify below)
 Was a chemical/bacteriological sample submitted to Department? Yes No
 If yes, mo/day/yr sample was submitted
 Water Well Disinfected? Yes No

5 TYPE OF BLANK CASING USED:
 1 Steel 2 PVC 3 RMP (SR) 4 ABS 5 Wrought iron 6 Asbestos-Cement 7 Fiberglass
 8 Concrete tile 9 Other (specify below)
 Blank casing diameter: 5 in. to 30 ft. Dia in. to ft. Dia in. to ft.
 Casing height above land surface: 18 in., weight lbs./ft. Wall thickness or gauge No. SDR-26
 TYPE OF SCREEN OR PERFORATION MATERIAL:
 1 Steel 2 Brass 3 Stainless steel 4 Galvanized steel 5 Fiberglass 6 Concrete tile 7 PVC 8 RMP (SR)
 9 Asbestos-cement 10 Other (specify)
 11 None used (open hole)
 SCREEN OR PERFORATION OPENINGS ARE:
 1 Continuous slot 2 Louvered shutter 3 Mill slot 4 Key punched 5 Gauzed wrapped 6 Wire wrapped 7 Torch cut 8 Saw cut
 9 Drilled holes 10 Other (specify)
 SCREEN-PERFORATED INTERVALS: From 30 ft. to 60 ft. From ft. to ft.
 GRAVEL PACK INTERVALS: From NONE ft. to ft. From ft. to ft.

6 GROUT MATERIAL: 1 Neat cement 2 Cement grout 3 Bentonite 4 Other
 Grout Intervals: From 3 ft. to 24 ft. From ft. to ft.
 What is the nearest source of possible contamination:
 1 Septic tank 2 Sewer lines 3 Watertight sewer lines 4 Lateral lines 5 Cess pool 6 Seepage pit 7 Pit privy 8 Sewage lagoon 9 Feedyard
 10 Livestock pens 11 Fuel storage 12 Fertilizer storage 13 Insecticide storage
 14 Abandoned water well 15 Oil well/Gas well 16 Other (specify below)
 Direction from well? South East How many feet? 54'

FROM	TO	LITHOLOGIC LOG	FROM	TO	PLUGGING INTERVALS
0	3	Topsoil Blk			
3	17	Clay Tan & Sandy			
17	27	Red Rock			
27	31	Shale Green			
31	40	LIME Lite Gray			
40	43	Shale Lite Gray			
43	51	LIME White			
51	60	Shale Yel			

7 CONTRACTOR'S OR LANDOWNER'S CERTIFICATION: This water well was (1) constructed, (2) reconstructed, or (3) plugged under my jurisdiction and was completed on (mo/day/year) Aug 3 96 and this record is true to the best of my knowledge and belief. Kansas Water Well Contractor's License No. 218 This Water Well Record was completed on (mo/day/yr) Aug 30 96 under the business name of Linn Water Well Dnlg by (signature) Joseph A. Zinn

OFFICE USE ONLY
T
R
EW
SEC.