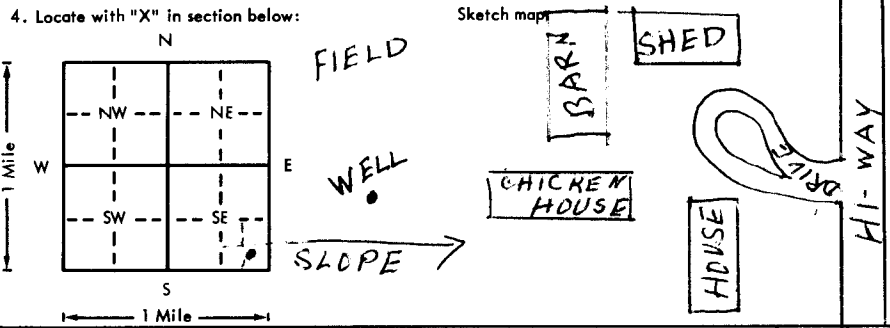


USE TYPEWRITER OR BALL POINT PEN-PRESS FIRMLY, PRINT CLEARLY.

WATER WELL RECORD
KSA 82a-1201-1215

Kansas Department of Health and Environment-Division of Environment
(Water well Contractors)
Topeka, Kansas 66620

1. Location of well:	County Dickinson	Fraction SE 1/4 SE 1/4 SE 1/4	Section number 32	Township number T 12 S	Range number R 3 E/W
2. Distance and direction from nearest town or city: 1 mile south Street address of well location if in city: 5 west of Chapman			3. Owner of well: Carl McDonald R.R. or street: R.R. #5 City, state, zip code: Abilene, Kansas 67410		
4. Locate with "X" in section below: 			6. Bore hole dia. 8 in. Completion date 4/12/76 Well depth 47 ft.		
5. Type and color of material			7. <input checked="" type="checkbox"/> Cable tool <input type="checkbox"/> Rotary <input type="checkbox"/> Driven <input type="checkbox"/> Dug <input type="checkbox"/> Hollow rod <input type="checkbox"/> Jetted <input type="checkbox"/> Bored <input type="checkbox"/> Reverse rotary		
			8. Use: <input checked="" type="checkbox"/> Domestic <input type="checkbox"/> Public supply <input type="checkbox"/> Industry <input type="checkbox"/> Irrigation <input type="checkbox"/> Air conditioning <input type="checkbox"/> Stack <input type="checkbox"/> Lawn <input type="checkbox"/> Oil field water <input type="checkbox"/> Other		
			9. Casing: Material Plot Height: Above ground 18" Threaded <input type="checkbox"/> Welded <input checked="" type="checkbox"/> Surface 81 in. RMP <input type="checkbox"/> PVC <input checked="" type="checkbox"/> Weight 18 lbs./ft. Dia. 5 in. to 47 ft. depth Wall Thickness: inches or Dia. 0.258 in. to 0.258 ft. depth gage No. 0.258		
			10. Screen: Manufacturer's name Western Plastics Type PVC Dia. 5" Slot/gauze 3/32 Length 20' Set between 27 ft. and 47 ft. ft. and 47 ft. Gravel pack? Yes Size range of material 1/16 to 3/8		
			11. Static water level: 27 ft. below land surface Date 4/12/76 mo./day/yr.		
			12. Pumping level below land surfaces: ft. after 20 hrs. pumping 20 g.p.m. ft. after 20 hrs. pumping 20 g.p.m. Estimated maximum yield 20 g.p.m.		
			13. Water sample submitted: No Yes <input checked="" type="checkbox"/> No <input type="checkbox"/> Date 4/12/76 mo./day/yr.		
			14. Well head completion: <input type="checkbox"/> Pitless adapter 18 inches above grade		
			15. Well grouted? Yes With: <input checked="" type="checkbox"/> Neat cement <input type="checkbox"/> Bentonite <input type="checkbox"/> Concrete Depth: From 0 ft. to 10 ft.		
			16. Nearest source of possible contamination: chicken house ft. 200' Direction east Type house Well disinfected upon completion? <input checked="" type="checkbox"/> Yes <input type="checkbox"/> No		
			17. Pump: <input checked="" type="checkbox"/> Not installed Manufacturer's name _____ Model number _____ HP _____ Volts _____ Length of drop pipe _____ ft. capacity _____ g.p.m. Type: <input type="checkbox"/> Submersible <input type="checkbox"/> Turbine <input type="checkbox"/> Jet <input type="checkbox"/> Reciprocating <input type="checkbox"/> Centrifugal <input type="checkbox"/> Other		
18. Elevation:			20. Water well contractor's certification: This well was drilled under my jurisdiction and this report is true to the best of my knowledge and belief. Rader Drilling Co. 194 Business name _____ License No. _____ Address Carlton, Kansas 67429 Signed Brad E. Rader Date 5-12-76 Authorized representative		
19. Remarks:					

Forward the white, blue and pink copies to the Department of Health and Environment

Form WWC-5