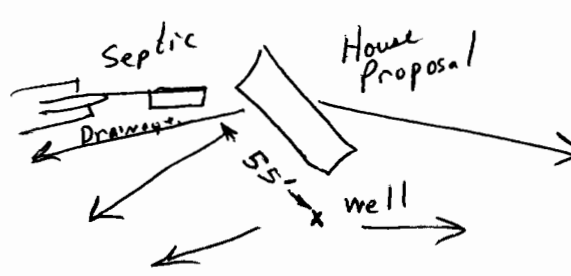


USE TYPEWRITER OR BALL POINT PEN-PRESS FIRMLY, PRINT CLEARLY.

WATER WELL RECORD
KSA 82a-1201-1215

Kansas Department of Health and Environment-Division of Environment
(Water well Contractors)
Topeka, Kansas 66620

1. Location of well:	County Dickinson	Fraction NW 1/4 NE 1/4 NE 1/4	Section number 33	Township number T 12 S R 3 E/W	Range number 3
2. Distance and direction from nearest town or city: 2 mile N and 2 mile E of Detroit, Kan			3. Owner of well: Elmer Shetron R.R. or street: RT 1 City, state, zip code: Solomon, Kan		
4. Locate with "X" in section below: N W E S 1 Mile		Sketch map: 		6. Bore hole dia. 6 1/4 in. Completion date 6-14-76 Well depth 67 ft.	
5. Type and color of material		From	To	7. <input checked="" type="checkbox"/> Cable tool <input type="checkbox"/> Rotary <input type="checkbox"/> Driven <input type="checkbox"/> Dug <input type="checkbox"/> Hollow rod <input type="checkbox"/> Jetted <input type="checkbox"/> Bored <input type="checkbox"/> Reverse rotary	
Topsoil - Bk		0	2	8. Use: <input checked="" type="checkbox"/> Domestic <input type="checkbox"/> Public supply <input type="checkbox"/> Industry <input type="checkbox"/> Irrigation <input type="checkbox"/> Air conditioning <input type="checkbox"/> Stack <input checked="" type="checkbox"/> Lawn <input type="checkbox"/> Oil field water <input type="checkbox"/> Other	
LIME - Yel		2	14	9. Casing: Material PVC Height: Above or below Threaded <input type="checkbox"/> Welded <input checked="" type="checkbox"/> Surface 16 in. RMP <input checked="" type="checkbox"/> PVC Weight _____ lbs./ft. Dia. 5 in. to 49 ft. depth Wall Thickness: _____ inches or Dia. _____ in. to _____ ft. depth gage No. .200	
Shale - Yel		14	15	10. Screen: Manufacturer's name Sunflower Type RMP Dia. 5" Slo/gauze YB Length 18' Set between 49 ft. and 67 ft. _____ ft. and _____ ft. Gravel pack? NO Size range of material _____	
LIME - Yel		15	19	11. Static water level: _____ mo./day/yr. 42 ft. below land surface Date 6-14-76	
Shale - Gray		19	29	12. Pumping level below land surfaces: _____ ft. after _____ hrs. pumping _____ g.p.m. _____ ft. after _____ hrs. pumping _____ g.p.m. Estimated maximum yield 25 g.p.m.	
Red Rock - Lite Brn.		29	39	13. Water sample submitted: _____ mo./day/yr. Yes <input type="checkbox"/> No <input checked="" type="checkbox"/> Date _____	
Red Rock - Red		39	49	14. Well head completion: <input type="checkbox"/> Pitless adapter 16 inches above grade	
LIME - wht 49 H2O		49	55	15. Well grouted? Yes With: <input type="checkbox"/> Neat cement <input type="checkbox"/> Bentonite <input checked="" type="checkbox"/> Concrete Depth: From 3 ft. to 13 ft.	
Shale - lite		55	62	16. Nearest source of possible contamination: ft. 55 Direction NW Type Sewage Well disinfected upon completion? <input checked="" type="checkbox"/> Yes <input type="checkbox"/> No	
LIME - Gray		62	67	17. Pump: <input checked="" type="checkbox"/> Not installed Manufacturer's name _____ Model number _____ HP _____ Volts _____ Length of drop pipe _____ ft. capacity _____ g.p.m. Type: <input type="checkbox"/> Submersible <input type="checkbox"/> Turbine <input type="checkbox"/> Jet <input type="checkbox"/> Reciprocating <input type="checkbox"/> Centrifugal <input type="checkbox"/> Other	
(Use a second sheet if needed)					
18. Elevation:	19. Remarks: Concrete slab 4'x4'x4" of reinforced concrete to be installed by customer Elmer Shetron			20. Water well contractor's certification: This well was drilled under my jurisdiction and this report is true to the best of my knowledge and belief. Ann Water Well Drilling 210 Business name License No. Address Lost Springs, Kan Signed Joseph A. Ann Date 6-14-76 Authorized representative	

12-33-33 NW 1/4 NE