


1 LOCATION OF WATER WELL: Fraction NW Section Number 35 Township Number T 12 S Range Number R 3 (E)*
 County: Dickinson Distance and direction from nearest town or city street address of well if located within city?

2 1/2 miles West of Chapman, Ks

2 WATER WELL OWNER: David Jury Board of Agriculture, Division of Water Resources
 RR#, St. Address, Box #: Rt 2 Application Number:
 City, State, ZIP Code: Chapman, Kansas 67431

3 LOCATE WELL'S LOCATION WITH AN "X" IN SECTION BOX: 4 DEPTH OF COMPLETED WELL: 132 ft. ELEVATION:
 Depth(s) Groundwater Encountered 1. 119 ft. 2. ft. 3. ft.

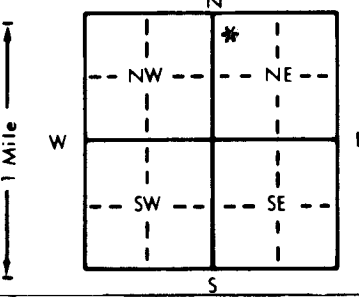

WELL'S STATIC WATER LEVEL 91 ft. below land surface measured on mo/day/yr 1 / 6 / 90
 Pump test data: Well water was ft. after hours pumping gpm
 Est. Yield 15 gpm: Well water was ft. after hours pumping gpm
 Bore Hole Diameter 9 in. to 132 ft., and in. to ft.
 WELL WATER TO BE USED AS: 5 Public water supply 8 Air conditioning 11 Injection well
 1 Domestic 3 Feedlot 6 Oil field water supply 9 Dewatering 12 Other (Specify below)
 2 Irrigation 4 Industrial 7 Lawn and garden only 10 Monitoring well
 Was a chemical/bacteriological sample submitted to Department? Yes No *; If yes, mo/day/yr sample was submitted
 Water Well Disinfected? Yes * No

5 TYPE OF BLANK CASING USED: 5 Wrought iron 8 Concrete tile CASING JOINTS: Glued * Clamped
 1 Steel 3 RMP (SR) 6 Asbestos-Cement 9 Other (specify below) Welded
 2 PVC 4 ABS 7 Fiberglass Threaded.....

Blank casing diameter 5 in. to 132 ft., Dia in. to ft., Dia in. to ft.
 Casing height above land surface 14 in., weight 160 lbs./ft. Wall thickness or gauge No. 214

TYPE OF SCREEN OR PERFORATION MATERIAL: 7 PVC 10 Asbestos-cement
 1 Steel 3 Stainless steel 5 Fiberglass 8 RMP (SR) 11 Other (specify)
 2 Brass 4 Galvanized steel 6 Concrete tile 9 ABS 12 None used (open hole)

SCREEN OR PERFORATION OPENINGS ARE: 5 Gauzed wrapped 8 Saw cut 11 None (open hole)
 1 Continuous slot 3 Mill slot 6 Wire wrapped 9 Drilled holes
 2 Louvered shutter 4 Key punched 7 Torch cut 10 Other (specify)

SCREEN-PERFORATED INTERVALS: From 92 ft. to 132 ft., From ft. to ft.
 From ft. to ft., From ft. to ft.
 GRAVEL PACK INTERVALS: From 24 ft. to 132 ft., From ft. to ft.
 From ft. to ft., From ft. to ft.

6 GROUT MATERIAL: 1 Neat cement 2 Cement grout 3 Bentonite 4 Other
 Grout Intervals: From 3 ft. to 24 ft., From ft. to ft., From ft. to ft.

What is the nearest source of possible contamination:
 1 Septic tank 4 Lateral lines 7 Pit privy 10 Livestock pens 14 Abandoned water well
 2 Sewer lines 5 Cess pool 8 Sewage lagoon 11 Fuel storage 15 Oil well/Gas well
 3 Watertight sewer lines 6 Seepage pit 9 Feedyard 12 Fertilizer storage 16 Other (specify below)
 13 Insecticide storage

Direction from well? NORTH How many feet? 118

FROM	TO	LITHOLOGIC LOG	FROM	TO	PLUGGING INTERVALS
0	1	DARK TOP SOIL	79	99	RED SHALE & GRAY SHALE
1	7	BROWN SANDY CLAY	99	104	LITE COLOR SHALE
7	11	BROWN CLAY	104	105	LITE COLOR LIMESTONE
11	13	LITE COLOR CLAY	105	107	LITE COLOR SHALE
13	16	LIMESTONE	107	111	limestone
16	19	LITE COLOR SHALE & CLAY	111	114	GRAY SHALE
19	34	RED SHALE	114	119	LIMESTONE
34	38	LITE COLOR SHALE	119	121	LITE COLOR SHALE
38	40	LIMESTONE	121	123	LIMESTONE
40	41	LITE COLOR SHALE	123	132	GRAY CLAY & SHALE
41	56	LIMESTONE			
56	67	LITE COLOR SHALE			
67	69	DARK FLINT ROCK			
69	74	GRAY CLAY & SHALE			
74	79	LITE COLOR SHALE			

7 CONTRACTOR'S OR LANDOWNER'S CERTIFICATION: This water well was (1) constructed, (2) reconstructed, or (3) plugged under my jurisdiction and was completed on (mo/day/year) 1 / 6 / 90 and this record is true to the best of my knowledge and belief. Kansas Water Well Contractor's License No. 397. This Water Well Record was completed on (mo/day/yr) 1 / 22 / 90 under the business name of CENTRAL KANSAS DRILLING by (signature) Harold D. Martin