

CORRECTION(S) TO WATER WELL RECORD (WWC-5)
(to rectify lacking or incorrect information)

County: Dickinson

Location listed as:

Section-Township-Range: 24-125-34E

Fraction (1/4 1/4 1/4): NW SE SW

Location changed to:

24-125-3E

SE NE SW SW

Other changes: Initial statements: _____

Changed to: _____

Comments: _____


verification method: Written & legal descriptions, Dickinson County
online parcel search, and mapping tool & aerial photos
on KGS website. initials: DRD date: 5/31/2012

submitted by: Kansas Geological Survey, Data Resources Library, 1930 Constant Ave., Lawrence, KS 66047-3726
to: Kansas Dept of Health & Environment, Bureau of Water, 1000 SW Jackson, Suite 420, Topeka, KS 66612-1367.

1 LOCATION OF WATER WELL: Fraction NW 1/4 SE 1/4 SW 1/4 Section Number 24 Township Number T 12 S Range Number R 3-4 E/W

Distance and direction from nearest town or city street address of well if located within city?
 1 mile West of Chapman, Ks on Hwy 40 & 1 1/4 mile North & 2/3 miles West

2 WATER WELL OWNER: Tim & Katie Wieters
 RR#, St. Address, Box # : 880 Zeandale Rd Board of Agriculture, Division of Water Resources
 City, State, ZIP Code : Manhattan, Kansas 66502 Application Number:

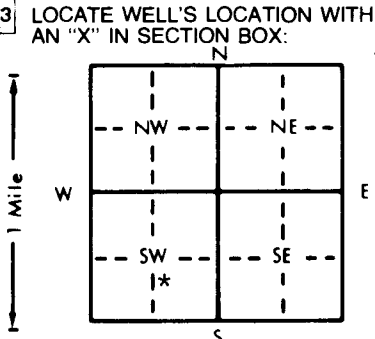

4 DEPTH OF COMPLETED WELL: 111 ft. ELEVATION:
 Depth(s) Groundwater Encountered 1. 72 ft. 2. ft. 3. ft.
 WELL'S STATIC WATER LEVEL: 68 ft. below land surface measured on mo/day/yr 7 / 28 / 96
 Pump test data: Well water was ft. after hours pumping gpm
 Est. Yield 15+ gpm: Well water was ft. after hours pumping gpm
 Bore Hole Diameter: 9 in. to 11.1 ft. and in. to ft.
 WELL WATER TO BE USED AS:
 5 Public water supply 8 Air conditioning 11 Injection well
 1 Domestic 3 Feedlot 6 Oil field water supply 9 Dewatering 12 Other (Specify below)
 2 Irrigation 4 Industrial 7 Lawn and garden only 10 Monitoring well
 Was a chemical/bacteriological sample submitted to Department? Yes No *; If yes, mo/day/yr sample was submitted
 Water Well Disinfected? Yes * No

5 TYPE OF BLANK CASING USED:
 1 Steel 3 RMP (SR) 5 Wrought iron 8 Concrete tile CASING JOINTS: Glued * Clamped
 2 PVC 4 ABS 6 Asbestos-Cement 9 Other (specify below) Welded
 7 Fiberglass Threaded
 Blank casing diameter 5 in. to 11.1 ft., Dia in. to ft., Dia in. to ft.
 Casing height above land surface 16 in., weight 160 lbs./ft. Wall thickness or gauge No. 214
 TYPE OF SCREEN OR PERFORATION MATERIAL:
 1 Steel 3 Stainless steel 5 Fiberglass 8 RMP (SR) 11 Other (specify)
 2 Brass 4 Galvanized steel 6 Concrete tile 9 ABS 12 None used (open hole)
 SCREEN OR PERFORATION OPENINGS ARE:
 1 Continuous slot 3 Mill slot 5 Gauzed wrapped 8 Saw cut 11 None (open hole)
 2 Louvered shutter 4 Key punched 6 Wire wrapped 9 Drilled holes
 7 Torch cut 10 Other (specify)
 SCREEN-PERFORATED INTERVALS: From 70 ft. to 96 ft., From ft. to ft.
 GRAVEL PACK INTERVALS: From 23 ft. to 111 ft., From ft. to ft.

6 GROUT MATERIAL: 1 Neat cement 2 Cement grout 3 Bentonite 4 Other
 Grout Intervals: From 3 ft. to 23 ft., From ft. to ft., From ft. to ft.
 What is the nearest source of possible contamination:
 1 Septic tank 4 Lateral lines 7 Pit privy 10 Livestock pens 14 Abandoned water well
 2 Sewer lines 5 Cess pool 8 Sewage lagoon 11 Fuel storage 15 Oil well/Gas well
 3 Watertight sewer lines 6 Seepage pit 9 Feedyard 12 Fertilizer storage 16 Other (specify below)
 13 Insecticide storage
 Direction from well? NORTHEAST WILL BE How many feet? 100

FROM	TO	LITHOLOGIC LOG	FROM	TO	PLUGGING INTERVALS
0	3	DARK TOP SOIL	103	105	LITE COLOR SHALEY CLAY
3	6	BROWN CLAY	105	109	RED COLOR SHALEY CLAY
6	10	TAN & LITE COLOR CLAY	109	111	LITE COLOR SHALEY CLAY
10	15	LITE COLOR LIMESTONE ROCK			
15	27	LITE COLOR CLAY			
27	28	LITE COLOR LIMESTONE & FLINT ROCK			
28	32	LITE COLOR SHALE			
32	35	LITE GRAY & RED SHALE MIXED			
35	47	RED CLAY & SHALE			
47	50	GRAY SHALE			
50	72	LITE COLOR LIMESTONE			
72	82	LITE COLOR SHALE & CLAY & MIXED GRAY			
82	84	LITE COLOR LIMESTONE & FLINT ROCK			
84	95	LITE COLOR SHALEY CLAY			
95	103	RED SHALE & MAROON COLOR			

7 CONTRACTOR'S OR LANDOWNER'S CERTIFICATION: This water well was (1) constructed, (2) reconstructed, or (3) plugged under my jurisdiction and was completed on (mo/day/year) 7 / 28 / 96 and this record is true to the best of my knowledge and belief. Kansas Water Well Contractor's License No. 397 This Water Well Record was completed on (mo/day/yr) 7 / 30 / 96 under the business name of CENTRAL KANSAS DRILLING by (signature) Harold D. Masten

OFFICE USE ONLY
T
R
E/W
SEC.
1/4
1/4
1/4