


1 LOCATION OF WATER WELL: Fraction Ne 1/4 Ne 1/4 Se 1/4 Section Number 7 Township Number T 12 S Range Number R 3 E
 County: Dickinson

Distance and direction from nearest town or city street address of well if located within city?
5500 N 4th E Abilene

2 WATER WELL OWNER: ~~Jason Peck~~ Jason Peck
 RR#, St. Address, Box #: 1946 Palmt. Rd. Board of Agriculture, Division of Water Resources
 City, State, ZIP Code: Enterprise, KS 67441 Application Number:

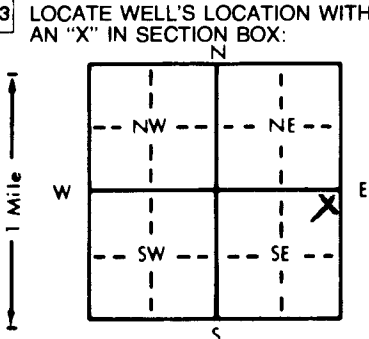

4 DEPTH OF COMPLETED WELL: 200 ft. ELEVATION:
 Depth(s) Groundwater Encountered 1. 178 ft. 2. ft. 3. ft.
 WELL'S STATIC WATER LEVEL 157 ft. below land surface measured on mo/day/yr 2-5-96
 Pump test data: Well water was ft. after hours pumping gpm
 Est. Yield 20 gpm Well water was ft. after hours pumping gpm
 Bore Hole Diameter 2 1/2 in. to 200 ft., and in. to ft.
 WELL WATER TO BE USED AS: 5 Public water supply 8 Air conditioning 11 Injection well
 1 Domestic 3 Feedlot 6 Oil field water supply 9 Dewatering 12 Other (Specify below)
 2 Irrigation 4 Industrial 7 Lawn and garden only 10 Monitoring well
 Was a chemical/bacteriological sample submitted to Department? Yes.....No...X.....; If yes, mo/day/yr sample was submitted
 Water Well Disinfected? Yes X No

5 TYPE OF BLANK CASING USED: 5 Wrought iron 8 Concrete tile CASING JOINTS: Glued X Clamped
 1 Steel 3 RMP (SR) 6 Asbestos-Cement 9 Other (specify below) Welded
 2 PVC 4 ABS 7 Fiberglass Threaded
 Blank casing diameter 5 in. to 175 ft. Dia. in. to ft. Dia. in. to ft.
 Casing height above land surface 12 in. weight CLASS 160 lbs./ft. Wall thickness or gauge No. 214
 TYPE OF SCREEN OR PERFORATION MATERIAL: 7 PVC 10 Asbestos-cement
 1 Steel 3 Stainless steel 5 Fiberglass 8 RMP (SR) 11 Other (specify)
 2 Brass 4 Galvanized steel 6 Concrete tile 9 ABS 12 None used (open hole)
 SCREEN OR PERFORATION OPENINGS ARE: 5 Gauzed wrapped 8 Saw cut 11 None (open hole)
 1 Continuous slot 3 Mill slot 6 Wire wrapped 9 Drilled holes
 2 Louvered shutter 4 Key punched 7 Torch cut 10 Other (specify)
 SCREEN-PERFORATED INTERVALS: From 175 ft. to 200 ft. From ft. to ft.
 From ft. to ft. From ft. to ft.
 GRAVEL PACK INTERVALS: From 23 ft. to 200 ft. From ft. to ft.
 From ft. to ft. From ft. to ft.

6 GROUT MATERIAL: 1 Neat cement 2 Cement grout 3 Bentonite 4 Other
 Grout Intervals: From 0 ft. to 23 ft. From ft. to ft. From ft. to ft.
 What is the nearest source of possible contamination:
 1 Septic tank 4 Lateral lines 7 Pit privy 10 Livestock pens 14 Abandoned water well
 2 Sewer lines 5 Cess pool 8 Sewage lagoon 11 Fuel storage 15 Oil well/Gas well
 3 Watertight sewer lines 6 Seepage pit 9 Feedyard 12 Fertilizer storage 16 Other (specify below)
 13 Insecticide storage
 Direction from well? How many feet? Will be 100'

FROM	TO	LITHOLOGIC LOG	FROM	TO	PLUGGING INTERVALS
0	20	Red Clay			
20	52	Yellow Clay + mixed Shale			
52	70	lime			
70	120	Yellow + Red Shale			
120	145	" Shale			
145	160	Gray "			
160	175	Red "			
175	178	lime			
178	179	Water			
179	200	Gray Shale			

7 CONTRACTOR'S OR LANDOWNER'S CERTIFICATION: This water well was (1) constructed, (2) reconstructed, or (3) plugged under my jurisdiction and was completed on (mo/day/year) 2-5-96 and this record is true to the best of my knowledge and belief. Kansas Water Well Contractor's License No. 180 This Water Well Record was completed on (mo/day/yr) 2-12-96 under the business name of Backhus Drilling by (signature) Paul Backhus

OFFICE USE ONLY
T
R
EW
SEC.