

CORRECTION TO WATER WELL RECORD (WWC-5)

The following correction(s) was made to the attached WWC-5 log, in order to file the item or to rectify lacking or incorrect information.

Fraction ( 1/4 1/4 1/4) Section-Township-Range changed:

listed as NW SW NW, 25-12S-4E

changed to NW SW NW, 25-12S-3E

Other changes: Initial statements: \_\_\_\_\_

\_\_\_\_\_

Changed to: \_\_\_\_\_

\_\_\_\_\_

Comments: \_\_\_\_\_

\_\_\_\_\_

verification method: Written description on form, and

Chapman 1:24,000 topo map initials: RPJ date: 7/1/99


submitted by: Kansas Geological Survey, Data Resources Library, 1930 Constant Ave., Lawrence, KS 66047-3726  
to: Kansas Dept of Health & Environment Bureau of Water Industrial Programs, Bldg 283, Forbes Field, KS 66620

1] LOCATION OF WATER WELL: Fraction NW 1/4 SW 1/4 NW 1/4 Section Number 25 Township Number T 12 S Range Number R 4 EW\*

Distance and direction from nearest town or city street address of well if located within city?  
 2 miles West of Chapman, Ks & 1 1/2 mile North

2] WATER WELL OWNER: Kenneth Wood  
 RR#, St. Address, Box #: 1822 Old Hwy 40 Board of Agriculture, Division of Water Resources  
 City, State, ZIP Code: Chapman, Kansas 67431 Application Number:

3] LOCATE WELL'S LOCATION WITH AN "X" IN SECTION BOX:

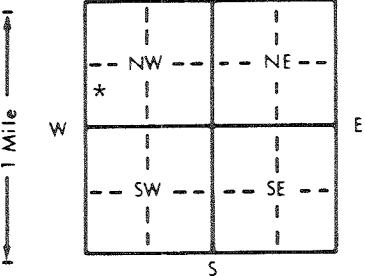

4] DEPTH OF COMPLETED WELL: 115 ft. ELEVATION:  
 Depth(s) Groundwater Encountered 1. 51 ft. 2. ft. 3. ft.  
 WELL'S STATIC WATER LEVEL 40 ft. below land surface measured on mo/day/yr 4 / 29 / 99  
 Pump test data: Well water was ft. after hours pumping gpm  
 Est. Yield 15+ gpm: Well water was ft. after hours pumping gpm  
 Bore Hole Diameter 9 in. to 11.5 ft. and in. to ft.  
 WELL WATER TO BE USED AS:  
 5 Public water supply 8 Air conditioning 11 Injection well  
 1 Domestic 3 Feedlot 6 Oil field water supply 9 Dewatering 12 Other (Specify below)  
 2 Irrigation 4 Industrial 7 Lawn and garden only 10 Monitoring well  
 Was a chemical/bacteriological sample submitted to Department? Yes No \* If yes, mo/day/yr sample was submitted  
 Water Well Disinfected? Yes \* No

5] TYPE OF BLANK CASING USED:  
 1 Steel 3 RMP (SR) 5 Wrought iron 8 Concrete tile CASING JOINTS: Glued \* Clamped  
 2 PVC 4 ABS 6 Asbestos-Cement 9 Other (specify below) Welded  
 7 Fiberglass Threaded

Blank casing diameter 5 in. to 11.5 ft. Dia in. to ft. Dia in. to ft.  
 Casing height above land surface 24 in., weight 160 lbs./ft. Wall thickness or gauge No. 214

TYPE OF SCREEN OR PERFORATION MATERIAL:  
 1 Steel 3 Stainless steel 5 Fiberglass 8 RMP (SR) 10 Asbestos-cement  
 2 Brass 4 Galvanized steel 6 Concrete tile 9 ABS 11 Other (specify)  
 12 None used (open hole)

SCREEN OR PERFORATION OPENINGS ARE:  
 1 Continuous slot 3 Mill slot 5 Gauzed wrapped 8 Saw cut 11 None (open hole)  
 2 Louvered shutter 4 Key punched 6 Wire wrapped 9 Drilled holes  
 7 Torch cut 10 Other (specify)

SCREEN-PERFORATED INTERVALS: From 3.5 ft. to 11.5 ft. From ft. to ft.  
 From ft. to ft. From ft. to ft.  
 GRAVEL PACK INTERVALS: From 2.3 ft. to 11.5 ft. From ft. to ft.  
 From ft. to ft. From ft. to ft.

6] GROUT MATERIAL: 1 Neat cement 2 Cement grout 3 Bentonite 4 Other  
 Grout intervals: From 3 ft. to 2.3 ft. From ft. to ft. From ft. to ft.

What is the nearest source of possible contamination:  
 1 Septic tank 4 Lateral lines 7 Pit privy 10 Livestock pens 14 Abandoned water well  
 2 Sewer lines 5 Cess pool 8 Sewage lagoon 11 Fuel storage 15 Oil well/Gas well  
 3 Watertight sewer lines 6 Seepage pit 9 Feedyard 12 Fertilizer storage 16 Other (specify below)  
 13 Insecticide storage

Direction from well? SOUTHWEST How many feet? 1400

FROM	TO	LITHOLOGIC LOG	FROM	TO	PLUGGING INTERVALS
0	2	DARK TOP SOIL	103	112	TAN LIMESTONE
2	9	BROWN CLAY	112	114	SOFT DARK SHALE
9	11	LITE COLOR SHALE	114	115	GRAY LIMESTONE
11	12	LITE COLOR LIMESTONE			
12	16	LITE COLOR SHALE & CLAY			
16	19	RED & GRAY SHALE MIXED			
19	29	RED SHALE			
29	32	LITE GRAY SHALE			
32	51	HARD LITE COLOR LIMESTONE			
51	61	LITE COLOR SHALE			
61	63	LIMESTONE & FLINT ROCK			
63	76	LITE COLOR SHALE & CLAY			
76	80	GRAY & RED SHALE MIXED			
80	85	RED SHALE			
85	103	GRAY & LITE RED SHALE MIXED			

7] CONTRACTOR'S OR LANDOWNER'S CERTIFICATION: This water well was (1) constructed, (2) reconstructed, or (3) plugged under my jurisdiction and was completed on (mo/day/year) 4 / 29 / 99 and this record is true to the best of my knowledge and belief. Kansas Water Well Contractor's License No. 397 This Water Well Record was completed on (mo/day/yr) 5 / 3 / 99 under the business name of CENTRAL KANSAS DRILLING by (signature) *Harold D. Martin*