


1] LOCATION OF WATER WELL:	Fraction	Section Number	Township Number	Range Number
County: <u>Dickinson</u>	<u>SW 1/4 SW 1/4 SW 1/4</u>	<u>34</u>	<u>T 12 S</u>	<u>R 3 E</u>

Distance and direction from nearest town or city street address of well if located within city?
6 miles East of Abilene, Ks on Hwy 40 to Nail Rd & 1 mile North at 2500 Ave & Nail Rd

2] WATER WELL OWNER: Mike Rankin Rd
 RR#, St. Address, Box # : 908 - 2600 Ave Board of Agriculture, Division of Water Resources
 City, State, ZIP Code : Abilene, Kansas 67410 Application Number:

3] LOCATE WELL'S LOCATION WITH AN "X" IN SECTION BOX:	4] DEPTH OF COMPLETED WELL <u>7.6</u> ft. ELEVATION:
---	--

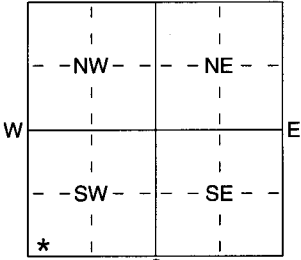

Depth(s) Groundwater Encountered 1. 3.7 ft. 2. ft. 3. ft.
 WELL'S STATIC WATER LEVEL 2.6 6 ft. below land surface measured on mo/day/yr 3 / 8 / 0.5
 Pump test data: Well water was ft. after hours pumping gpm
 Est. Yield 4.5 gpm: Well water was ft. after hours pumping gpm
 WELL WATER TO BE USED AS: 5 Public water supply 8 Air conditioning 11 Injection well
 1 Domestic 3 Feedlot 6 Oil field water supply 9 Dewatering 12 Other (Specify below)
 2 Irrigation 4 Industrial 7 Domestic (lawn & garden) 10 Monitoring well

Was a chemical/bacteriological sample submitted to Department? Yes No *; If yes, mo/day/yr sample was submitted
 Water Well Disinfected? Yes * No

5] TYPE OF BLANK CASING USED:

1 Steel	3 RMP (SR)	5 Wrought iron	8 Concrete tile	CASING JOINTS: Glued * Clamped
2 PVC	4 ABS	6 Asbestos-Cement	9 Other (specify below)	Welded
		7 Fiberglass		Threaded

Blank casing diameter 5 in. to 7.6 ft., Dia in. to ft., Dia in. to ft.
 Casing height above land surface 1.3 in., weight 2.00 lbs./ft. Wall thickness or gauge No. ~~2.50~~ 2.50

TYPE OF SCREEN OR PERFORATION MATERIAL:

1 Steel	3 Stainless Steel	5 Fiberglass	7 PVC	10 Asbestos-Cement
2 Brass	4 Galvanized Steel	6 Concrete tile	8 RMP (SR)	11 Other (Specify)
			9 ABS	12 None used (open hole)

SCREEN OR PERFORATION OPENINGS ARE:

1 Continuous slot	3 Mill slot	5 Gauzed wrapped	8 Saw cut	11 None (open hole)
2 Louvered shutter	4 Key punched	6 Wire wrapped	9 Drilled holes	
		7 Torch cut	10 Other (specify)	ft.

SCREEN-PERFORATED INTERVALS: From 3.6 ft. to 7.6 ft., From ft. to ft.
 From ft. to ft., From ft. to ft.
 GRAVEL PACK INTERVALS: From 2.6 ft. to 7.6 ft., From ft. to ft.
 From ft. to ft., From ft. to ft.

6] GROUT MATERIAL: 1 Neat cement 2 Cement grout 3 Bentonite 4 Other

Grout Intervals: From 3 ft. to 2.6 ft., From ft. to ft., From ft. to ft.

What is the nearest source of possible contamination:

1 Septic tank	4 Lateral lines	7 Pit privy	10 Livestock pens	14 Abandoned water well
2 Sewer lines	5 Cess pool	8 Sewage lagoon	11 Fuel storage	15 Oil well/Gas well
3 Watertight sewer lines	6 Seepage pit	9 Feedyard	12 Fertilizer storage	16 Other (specify below)
			13 Insecticide storage	

Direction from well? EAST WILL BE APPROX How many feet? 80 - 100

FROM	TO	LITHOLOGIC LOG	FROM	TO	PLUGGING INTERVALS
0	1	DARK TOP SOIL			
1	7	BROWN CLAY			
7	10	LITE COLOR LIMESTONE			
10	15	LITE COLOR CLAY & SHALE			
15	22	LITE COLOR LIMESTONE			
22	33	LITE COLOR SHALE & CLAY			
33	37	HARD LITE COLOR LIMESTONE			
37	44	LITE COLOR CLAY & SHALE			
44	58	MAROON SHALE			
58	76	BROWN CLAY & SHALE			

7] CONTRACTOR'S OR LANDOWNER'S CERTIFICATION: This water well was (1) constructed, (2) reconstructed, or (3) plugged under my jurisdiction and was completed on (mo/day/year) 3 / 8 / 0.5 and this record is true to the best of my knowledge and belief. Kansas Water Well Contractor's Licence No 397 This Water Well Record was completed on (mo/day/yr) 3 / 20 / 05 under the business name of CENTRAL KANSAS DRILLING by (signature) Harold R Martin