


1	LOCATION OF WATER WELL: County: <u>DICKINSON</u>	Fraction <u>SE 1/4 SE 1/4 NW 1/4</u>	Section Number <u>2</u>	Township Number <u>12 S</u>	Range Number <u>3 E</u>
---	-----------------------------------------------------	-----------------------------------------	----------------------------	--------------------------------	----------------------------

Distance and direction from nearest town or city street address of well if located within city?  
7 miles NW of Chapman, Kansas

2 WATER WELL OWNER: Walker Stone Co., Inc.  
 RR#, St. Address, Box #: P.O. Box 563 Board of Agriculture, Division of Water Resources  
 City, State, ZIP Code: Chapman, Kansas - 67431 Application Number: N/A

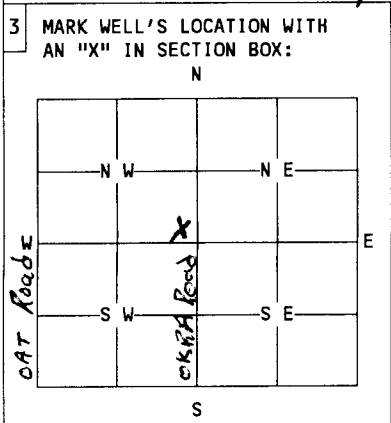

4 DEPTH OF WELL.....71.....ft.  
 WELL'S STATIC WATER LEVEL...35.....ft.  
 WELL WAS USED AS:  
 Domestic    5 Public Water Supply    9 Dewatering  
 2 Irrigation    6 Oil Field Water Supply    10 Monitoring Well  
 3 Feedlot    7 Lawn and Garden Only    11 Injection Well  
 4 Industrial    8 Air Conditioning    12 Other.....  
 Was a chemical/bacteriological sample submitted to Department? Yes....No...  
 If yes, mo/day/yr sample was submitted.....  
 Water Well Disinfected: Yes..... No.....

5 TYPE OF BLANK CASING USED:  
 1 Steel    3 RMP (SR)    5 Wrought    7 Fiberglass    9 Other (specify below)  
 2 PVC    4 ABS    6 Asbestos-Cement    8 Concrete Tile  
 Blank casing diameter...5".....in.    Was casing pulled? Yes..... No...  
 Casing height above or below land surface...60'.....in.

6 GROUT PLUG MATERIAL: 1 Neat cement    2 Cement grout    3 Bentonite    4 Other.....  
 Grout Plug Intervals: From.....ft. to.....ft., From.....ft. to.....ft., From..... to.....ft.  
 What is the nearest source of possible contamination:  
 1 Septic tank     6 Seepage pit     11 Fuel storage     16 Other (specify below)  
 2 Sewer lines     7 Pit privy     12 Fertilizer storage    NONE  
 3 Watertight sewer lines     8 Sewage lagoon     13 Insecticide storage  
 4 Lateral lines     9 Feedyard     14 Abandoned water well  
 5 Cess Pool     10 Livestock pens     15 Oil well/Gas well  
 Direction from well? .....    How many feet? .....

FROM	TO	PLUGGING MATERIALS
<u>71'</u>	<u>28'</u>	<u>Manufactured Sand</u>
<u>28'</u>	<u>5"</u>	<u>Limestone Screenings</u>
<u>5'</u>	<u>0'</u>	<u>clay</u>

7 CONTRACTOR'S OR LANDOWNER'S CERTIFICATION: This water well was plugged under my jurisdiction and was completed (mo/day/year)...9-29-98... and this record is true to the best of my knowledge and belief. Kansas Water Well Contractor's License No. ...N/A... This Water Well Record was completed on (mo/day/year) ...9-30-98... under the business name of ...Walker Stone Co., Inc.... by (signature) ...Tom L. Fire... Vice-Pres.

INSTRUCTIONS: Use typewriter or ball point pen. Please press firmly and print clearly. Please fill in blanks, underline or circle the correct answers. Send top three copies to Kansas Department of Health and Environment, Bureau of Water, Topeka, Kansas 66620-0001. Telephone: 913/296-3565. Send one to Water Well Owner and retain one for your records.