

WATER WELL RECORD Form WWC-5


Division of Water Resources App. No.

Well ID

Original Record Correction Change in Well Use

1 LOCATION OF WATER WELL: County: Dickinson Fraction: 1/4 NW 1/4 SW 1/4 SW 1/4 Section Number: 28 Township Number: T 12 S Range Number: R 3 E E W

2 WELL OWNER: Last Name: Dedonder First: Bruce Street or Rural Address where well is located: 2632 Mink Rd Abilene, Kansas

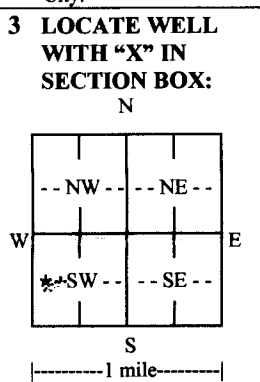

4 DEPTH OF COMPLETED WELL: 78 ft. Depth(s) Groundwater Encountered: 1) 4.3 ft. 2) ... ft. 3) ... ft., or 4) Dry Well

5 Latitude: ... (decimal degrees) Longitude: ... (decimal degrees) Datum: WGS 84 NAD 83 NAD 27

7 WELL WATER TO BE USED AS: 1. Domestic: Household, Lawn & Garden, Livestock, Irrigation, Feedlot, Industrial

Was a chemical/bacteriological sample submitted to KDHE? Yes No Water well disinfected? Yes No

8 TYPE OF CASING USED: Steel PVC Other CASING JOINTS: Glued Clamped Welded Threaded Casing diameter: 5 in. to 28 ft.

9 GROUT MATERIAL: Neat cement Cement grout Bentonite Other Grout Intervals: From 3 ft. to 28 ft.

Nearest source of possible contamination: Septic Tank Lateral Lines Pit Privy Livestock Pens Insecticide Storage

Table with columns: FROM, TO, LITHOLOGIC LOG, FROM, TO, LITHO. LOG (cont.) or PLUGGING INTERVALS. Rows include BROWN CLAY, LITE COLOR CLAY, LITE COLOR LIMESTONE, GRAY & MAROON SHALE, LITE COLOR SHALE, LITE COLOR LIMESTONE, LITE COLOR SHALE, DARK COLOR LIMESTONE.

11 CONTRACTOR'S OR LANDOWNER'S CERTIFICATION: This water well was constructed, reconstructed, or plugged under my jurisdiction and was completed on (mo-day-year) 3/26/15