

County: Dickinson Fraction: NW SW NW NE Sec. 26 T. 12 S R. 3 E

**CORRECTION(S) to WATER WELL COMPLETION RECORD Form WWC-5** (to rectify lacking or incorrect information)

Owner: KC Dist Corp of Engineers

**If location corrected, was listed as:**

Section-Township-Range: none listed

Fraction (1/4 calls): none listed

**Location changed to:**

S26-T12-R3E

NW SW NW NE

**Other changes:** Initial statements: \_\_\_\_\_

Changed to: \_\_\_\_\_

Comments: \_\_\_\_\_

Verification method: Used LEOWEB to enter Latitude/Longitude to get section, township, range and fraction. Verified location with the KGS mapper tool.

Initials: SH Date: 07-05-18

Submitted by:  Kansas Geological Survey, Data Resources Library, 1930 Constant Ave., Lawrence, KS 66047-3724

Kansas Dept. of Health & Environment, Bureau of Water, 1000 SW Jackson, Suite 420, Topeka, KS 66612-1367


**WATER WELL PLUGGING RECORD Form WWC-5P KSA 82a-1212 ID NO.**

<b>1 LOCATION OF WATER WELL:</b> County: Dickinson	Fraction ¼    ¼    ¼    ¼	Section Number	Township Number T    S	Range Number <input type="checkbox"/> E <input type="checkbox"/> W
---	------------------------------	----------------	---------------------------	---

Street/Rural Address of Well Location; if unknown, distance & direction from nearest town or intersection: If at owner's address, check here  3/4 mile west of intersection of Paint Rd. & 2700 Ave.

**Global Positioning Systems (GPS) information:**  
 Latitude: 38.985363244 (in decimal degrees)  
 Longitude: -97.064671015 (in decimal degrees)  
 Elevation: 1241.14  
 Horizontal Datum:  WGS84,  NAD83,  NAD27  
 Collection Method:  
 GPS unit (Make/Model: \_\_\_\_\_)  
 Digital Map/Photo,  Topographic Map,  Land Survey  
 Est. Accuracy:  < 3 m,  3-5 m,  5-15 m,  > 15 m

**2 WATER WELL OWNER:** KC Dist Corps of Engineers  
 RR#, St. Address, Box #: 601 E 12th St  
 City, State ZIP Code: Kansas City, MO, 64106

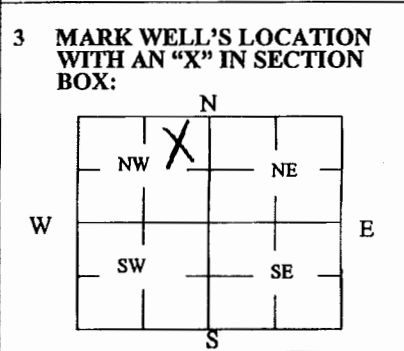

**4 DEPTH OF WELL** 99 ft.  
**WELL'S STATIC WATER LEVEL** 93.3 ft  
**WELL WAS USED AS:**  
 Domestic     Public Water Supply     Dewatering  
 Irrigation     Oil Field Water Supply     Monitoring  
 Feedlot     Domestic (Lawn & Garden)     Injection Well  
 Industrial     Air Conditioning     Other \_\_\_\_\_  
 Was a chemical/bacteriological sample submitted to Department? Yes  No

**5 TYPE OF BLANK CASING USED:**

Steel     RMP (SR)     Wrought     Fiberglass     Other (Specify below) \_\_\_\_\_  
 PVC     ABS     Asbestos-Cement     Concrete Tile

Blank casing diameter 2 in. Was casing pulled? Yes  No  If yes, how much 5.20 feet  
 Casing height above or below land surface \_\_\_\_\_ in.

**6 GROUT PLUG MATERIAL:**  Neat cement     Cement grout     Bentonite     Other cement/bentonite grout  
 Grout Plug Intervals: From 0 ft. to 99 ft., From \_\_\_\_\_ ft. to \_\_\_\_\_ ft., From \_\_\_\_\_ ft. to \_\_\_\_\_ ft.

What is the nearest source of possible contamination:

<input type="checkbox"/> Septic tank	<input type="checkbox"/> Seepage pit	<input type="checkbox"/> Fuel storage	<input checked="" type="checkbox"/> Other (specify below)
<input type="checkbox"/> Sewer lines	<input type="checkbox"/> Pit privy	<input type="checkbox"/> Fertilizer storage	Former Atlas Missile Site
<input type="checkbox"/> Watertight sewer lines	<input type="checkbox"/> Sewage lagoon	<input type="checkbox"/> Insecticide storage	
<input type="checkbox"/> Lateral lines	<input type="checkbox"/> Feedyard	<input type="checkbox"/> Abandoned water well	Direction from well? SW
<input type="checkbox"/> Cess pool	<input type="checkbox"/> Livestock pens	<input type="checkbox"/> Oil well/Gas well	How many feet? 500

FROM	TO	PLUGGING MATERIALS	FROM	TO	PLUGGING MATERIALS
0	99	94lb portland:1qt bent: 7.5 gal water			

**7 CONTRACTOR'S OR LANDOWNER'S CERTIFICATION:** This water well was plugged under my jurisdiction and was completed on (mo/day/year) 2/21/2018 and this record is true to the best of my knowledge and belief. Kansas Water Well Contractor's License No. US Army COE. This Water Well Record was completed on (mo/day/year) 2/28/2018 under the business name of US Army Corps of Engineers- Kansas City Dist by (signature) Zack Parsons

Send one white copy to Kansas Department of Health & Environment, Geology Section, 1000 SW Jackson Street, Ste. 420, Topeka, KS 66612-1367. Send one copy to WATER WELL OWNER and retain one for your records.  
 Visit us at <http://www.kdheks.gov/waterwell/index.html> Telephone 785-296-5524.