

dickinson


MW# 6

1 LOCATION OF WATER WELL: County: <u>GEARY</u>	Fraction <u>SW 1/4 SE 1/4 SE 1/4</u>	Section Number <u>19</u>	Township Number <u>T 12 S</u>	Range Number <u>R 4 E</u>
---	---	-----------------------------	----------------------------------	------------------------------

Distance and direction from nearest town or city street address of well if located within city?
HWY 260 and I-70 South East Corner

2 WATER WELL OWNER: FINA OIL & CHEMICAL CO
 RR#, St. Address, Box #: P.O. Box 2126
 City, State, ZIP Code: Dallas tx 75211

Board of Agriculture, Division of Water Resources
 Application Number:

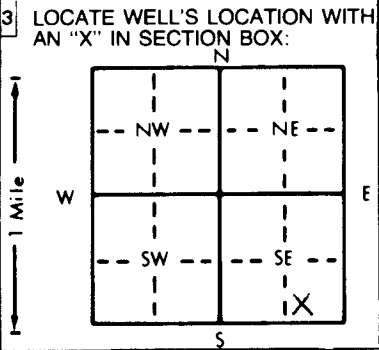

4 DEPTH OF COMPLETED WELL: 21 ft. ELEVATION: _____

Depth(s) Groundwater Encountered: 1 ft. 2. _____ ft. 3. _____ ft.

WELL'S STATIC WATER LEVEL: 0 ft. below land surface measured on mo/day/yr

Pump test data: Well water was _____ ft. after _____ hours pumping _____ gpm

Est. Yield _____ gpm: Well water was _____ ft. after _____ hours pumping _____ gpm

Bore Hole Diameter: 7 1/4 in. to 21 in. and _____ in. to _____ ft.

WELL WATER TO BE USED AS:

5 Public water supply	8 Air conditioning	11 Injection well
1 Domestic	3 Feedlot	6 Oil field water supply
2 Irrigation	4 Industrial	7 Lawn and garden only
		<input checked="" type="radio"/> Monitoring well

Was a chemical/bacteriological sample submitted to Department? Yes _____ No _____; If yes, mo/day/yr sample was submitted _____

Water Well Disinfected? Yes _____ No _____

5 TYPE OF BLANK CASING USED:

1 Steel	3 RMP (SR)	5 Wrought iron	8 Concrete tile	CASING JOINTS: Glued _____ Clamped _____
<input checked="" type="radio"/> PVC	4 ABS	6 Asbestos-Cement	9 Other (specify below)	Welded _____
		7 Fiberglass		Threaded _____

Blank casing diameter: 2 in. to 11 in. Dia _____ in. to _____ ft. Dia _____ in. to _____ ft.

Casing height above land surface: 0 in., weight SCHED 40 lbs./ft. Wall thickness or gauge No. _____

TYPE OF SCREEN OR PERFORATION MATERIAL:

1 Steel	3 Stainless steel	5 Fiberglass	8 RMP (SR)	10 Asbestos-cement
2 Brass	4 Galvanized steel	6 Concrete tile	9 ABS	11 Other (specify) _____
				12 None used (open hole)

SCREEN OR PERFORATION OPENINGS ARE:

1 Continuous slot	<input checked="" type="radio"/> Mill slot <u>0.10</u>	5 Gauzed wrapped	8 Saw cut	11 None (open hole)
2 Louvered shutter	4 Key punched	6 Wire wrapped	9 Drilled holes	
		7 Torch cut	10 Other (specify) _____	

SCREEN-PERFORATED INTERVALS: From 21 ft. to 11 ft., From _____ ft. to _____ ft.

GRAVEL PACK INTERVALS: From 21 ft. to 9 ft., From _____ ft. to _____ ft.

6 GROUT MATERIAL: 1 Neat cement 2 Cement grout 3 Bentonite 4 Other _____

Grout Intervals: From 7 ft. to 0 ft., From 9 ft. to 7 ft., From _____ ft. to _____ ft.

What is the nearest source of possible contamination:

1 Septic tank	4 Lateral lines	7 Pit privy	10 Livestock pens	14 Abandoned water well
2 Sewer lines	5 Cess pool	8 Sewage lagoon	11 Fuel storage	15 Oil well/Gas well
3 Watertight sewer lines	6 Seepage pit	9 Feedyard	12 Fertilizer storage	16 Other (specify below)
			13 Insecticide storage	

Direction from well? _____ How many feet? _____

FROM	TO	LITHOLOGIC LOG	FROM	TO	PLUGGING INTERVALS
					TOP 3' OF CASING REMOVED
					GROUTED TO SURFACE WITH TRSMIE METHOD
					TOTAL VOLUME 4.1 GALLONS

7 CONTRACTOR'S OR LANDOWNER'S CERTIFICATION: This water well was (1) constructed, (2) reconstructed, or plugged under my jurisdiction and was completed on (mo/day/year) 1-11-96 and this record is true to the best of my knowledge and belief. Kansas Water Well Contractor's License No. 575 This Water Well Record was completed on (mo/day/yr) 2-22-96 under the business name of RJITZ ENVIRONMENTAL SERVICE by (signature) [Signature]

OFFICE USE ONLY
T
R
EW
SEC.
1/4
1/4
1/4