


1 LOCATION OF WATER WELL: Fraction SW 1/4 SE 1/4 SE 1/4 Section Number 19 Township Number T 12 S Range Number R 4 EW
 County: GEARY dickinson
 Distance and direction from nearest town or city street address of well if located within city?
HWY 260 & I-70 SOUTHEAST CORNER

2 WATER WELL OWNER: FINA OIL & CHEMICAL CO.
 RR#, St. Address, Box # P.O. BOX 2126 DALLAS, TEXAS 75211
 City, State, ZIP Code Board of Agriculture, Division of Water Resources
 Application Number:

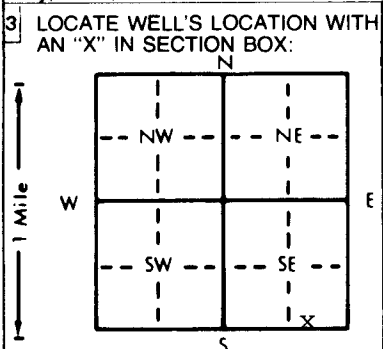

4 DEPTH OF COMPLETED WELL . . . 1.4 . . . ft. ELEVATION:
 Depth(s) Groundwater Encountered 1. ft. 2. ft. 3. ft.
 WELL'S STATIC WATER LEVEL ft. below land surface measured on mo/day/yr
 Pump test data: Well water was ft. after hours pumping gpm
 Est. Yield gpm: Well water was ft. after hours pumping gpm
 Bore Hole Diameter . . . 7 1/4 . . . in. to . . . 1.4 . . . ft., and in. to ft.
 WELL WATER TO BE USED AS: 5 Public water supply 8 Air conditioning 11 Injection well
 1 Domestic 3 Feedlot 6 Oil field water supply 9 Dewatering 12 Other (Specify below)
 2 Irrigation 4 Industrial 7 Lawn and garden only Monitoring well
 Was a chemical/bacteriological sample submitted to Department? Yes No; If yes, mo/day/yr sample was sub-
 mitted Water Well Disinfected? Yes No

5 TYPE OF CASING USED: 5 Wrought iron 8 Concrete tile CASING JOINTS: Glued Clamped
 1 Steel 3 RMP (SR) 6 Asbestos-Cement 9 Other (specify below) Welded
 PVC 4 ABS 7 Fiberglass Threaded . . .
 Blank casing diameter . . . 2 . . . in. to . . . 1.4 . . . ft., Dia in. to ft., Dia in. to ft.
 Casing height above land surface . . . 0 . . . in., weight . . . SCHED. 40 . . . lbs./ft. Wall thickness or gauge No.
 TYPE OF SCREEN OR PERFORATION MATERIAL: PVC 10 Asbestos-cement
 1 Steel 3 Stainless steel 5 Fiberglass 8 RMP (SR) 11 Other (specify)
 2 Brass 4 Galvanized steel 6 Concrete tile 9 ABS 12 None used (open hole)
 SCREEN OR PERFORATION OPENINGS ARE: 5 Gauzed wrapped 8 Saw cut 11 None (open hole)
 1 Continuous slot 3 Mill slot 6 Wire wrapped 9 Drilled holes
 2 Louvered shutter 4 Key punched 7 Torch cut 10 Other (specify)
 SCREEN-PERFORATED INTERVALS: From . . . 1.4 . . . ft. to . . . 1.0 . . . ft., From ft. to ft.
 From ft. to ft., From ft. to ft.
 GRAVEL PACK INTERVALS: From . . . 1.4 . . . ft. to . . . 8 . . . ft., From ft. to ft.
 From ft. to ft., From ft. to ft.

6 GROUT MATERIAL: 1 Neat cement 2 Cement grout 3 Bentonite 4 Other
 Grout Intervals: From . . . 6 . . . ft. to . . . 0 . . . ft., From . . . 8 . . . ft. to . . . 6 . . . ft., From ft. to ft.
 What is the nearest source of possible contamination:
 1 Septic tank 4 Lateral lines 7 Pit privy 10 Livestock pens 14 Abandoned water well
 2 Sewer lines 5 Cess pool 8 Sewage lagoon 11 Fuel storage 15 Oil well/Gas well
 3 Watertight sewer lines 6 Seepage pit 9 Feedyard 12 Fertilizer storage 16 Other (specify below)
 13 Insecticide storage
 Direction from well? How many feet?

FROM	TO	LITHOLOGIC LOG	FROM	TO	PLUGGING INTERVALS
					TOP 3' OF CASING REMOVED. GROUTED TREMIE METHOD TO SURFACE. TOTAL VOLUME = 2.4 GALLONS

7 CONTRACTOR'S OR LANDOWNER'S CERTIFICATION: This water well was (1) constructed, (2) reconstructed, or (3) plugged under my jurisdiction and was completed on (mo/day/year) . . . 1-11-96 . . . and this record is true to the best of my knowledge and belief. Kansas Water Well Contractor's License No. . . 575 . . . This Water Well Record was completed on (mo/day/yr) . . . 2-22-96 . . . under the business name of KURTZ ENVIRONMENTAL SERVICE by (signature)

OFFICE USE ONLY T R E W SEC. 1/4 1/4 1/4