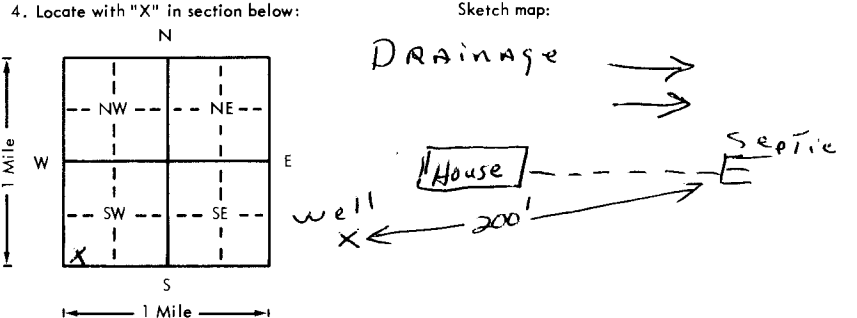


USE TYPEWRITER OR BALL POINT PEN-PRESS FIRMLY, PRINT CLEARLY.

WATER WELL RECORD
KSA 82a-1201-1215

Kansas Department of Health and Environment-Division of Environment
(Water well Contractors)
Topeka, Kansas 66620

1. Location of well:		County GEARY	Fraction SW 1/4 SW 1/4 SW 1/4	Section number 1	Township number T 12 3	Range number R 1 2W
2. Distance and direction from nearest town or city: 5 W. of Street address of well location if in city: Jct. City, Ks.			3. Owner of well: Richard Rothfuss R.R. or street: RFO 3 Box 138 City, state, zip code: Jct. City, Kansas			
4. Locate with "X" in section below: Sketch map: 			6. Bore hole dia. 8 in. Completion date _____ Well depth 160 ft. 10-31-77			
5. Type and color of material			7. <input checked="" type="checkbox"/> Cable tool <input checked="" type="checkbox"/> Rotary <input type="checkbox"/> Driven <input type="checkbox"/> Dug <input type="checkbox"/> Hollow rod <input type="checkbox"/> Jetted <input type="checkbox"/> Bored <input type="checkbox"/> Reverse rotary			
			8. Use: <input checked="" type="checkbox"/> Domestic <input type="checkbox"/> Public supply <input type="checkbox"/> Industry <input type="checkbox"/> Irrigation <input type="checkbox"/> Air conditioning <input type="checkbox"/> Stock <input type="checkbox"/> Lawn <input type="checkbox"/> Oil field water <input type="checkbox"/> Other			
			9. Casing: Material PVC Height: Above or below Threaded <input type="checkbox"/> Welded <input type="checkbox"/> Surface 24 in. RMP <input type="checkbox"/> PVC glue Weight 2.74 lbs./ft. Dia. 5 in. to 160 ft. depth Wall Thickness: inches or Dia. _____ in. to _____ ft. depth gage No. .258			
			10. Screen: Manufacturer's name _____ Pumpco MPI Type PVC Dia. 5 Slot/gauze .060 Length 40 Set between 100 ft. and 140 ft. _____ ft. and _____ ft. Gravel pack? <input checked="" type="checkbox"/> Size range of material 1/4 x 1/8			
			11. Static water level: _____ mo./day/yr. 80 ft. below land surface Date 10-31-77			
			12. Pumping level below land surfaces: _____ ft. after _____ hrs. pumping _____ g.p.m. _____ ft. after _____ hrs. pumping _____ g.p.m. Estimated maximum yield 30 g.p.m.			
			13. Water sample submitted: _____ ma./day/yr. <input type="checkbox"/> Yes <input checked="" type="checkbox"/> No Date _____			
			14. Well head completion: CAP <input type="checkbox"/> Pitless adapter 24 Inches above grade			
			15. Well grouted? <input checked="" type="checkbox"/> With: <input checked="" type="checkbox"/> Neat cement <input type="checkbox"/> Bentonite <input type="checkbox"/> Concrete Depth: From 5 ft. to 15 ft.			
			16. Nearest source of possible contamination: ft. 300 Direction E Type Septic Well disinfected upon completion? <input checked="" type="checkbox"/> Yes <input type="checkbox"/> No			
			17. Pump: <input checked="" type="checkbox"/> Not installed Manufacturer's name _____ Model number _____ HP _____ Volts _____ Length of drop pipe _____ ft. capacity _____ g.p.m. Type: <input type="checkbox"/> Submersible <input type="checkbox"/> Turbine <input type="checkbox"/> Jet <input type="checkbox"/> Reciprocating <input type="checkbox"/> Centrifugal <input type="checkbox"/> Other			
18. Elevation: Topography: <input checked="" type="checkbox"/> Hill <input type="checkbox"/> Slope <input type="checkbox"/> Upland <input type="checkbox"/> Valley			19. Remarks: Owner to install slab			
			20. Water well contractor's certification: This well was drilled under my jurisdiction and this report is true to the best of my knowledge and belief. Strader Drilling Co. Inc. 182 Business name License No. _____ Address RT 1 Holton, Ks Signed Dale Anderson Date 11-2-77 Authorized representative			

T 12 3
 R 1 2W
 Sec 1
 SW 1/4 SW 1/4 SW 1/4