

**CORRECTION(S) TO WATER WELL RECORD (WWC-5)**

(to rectify lacking or incorrect information)

County: Geary

**Location listed as:**

**Location changed to:**

Section-Township-Range: 23-12S-4-5E

23-12S-4E

Fraction ( 1/4 1/4 1/4): NE SW SE

NE SW SE

**Other changes:** Initial statements: \_\_\_\_\_

Changed to: \_\_\_\_\_

Comments: \_\_\_\_\_

verification method: Written & legal descriptions, position on plat map, and mapping tool on KGS website.

initials: DRS date: 5/25/2012

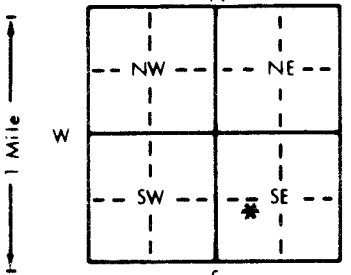
submitted by: Kansas Geological Survey, Data Resources Library, 1930 Constant Ave., Lawrence, KS 66047-3726

to: Kansas Dept of Health & Environment, Bureau of Water, 1000 SW Jackson, Suite 420, Topeka, KS 66612-1367.

1 LOCATION OF WATER WELL: Fraction NE 1/4 SW 1/4 SE 1/4 Section Number 23 Township Number T 12 S Range Number R 4-5 E  
 County: Geary

Distance and direction from nearest town or city street address of well if located within city?  
3 3/4 miles East of Chapman, Ks on old Hwy 40

2 WATER WELL OWNER: John Fansler  
 RR#, St. Address, Box #: 131 Belmont Board of Agriculture, Division of Water Resources  
 City, State, ZIP Code: Junction City, Kansas 66441 Application Number:

3 LOCATE WELL'S LOCATION WITH AN "X" IN SECTION BOX:  
  
 4 DEPTH OF COMPLETED WELL: 96 ft. ELEVATION:  
 Depth(s) Groundwater Encountered 1. 83 ft. 2. ft. 3. ft.  
 WELL'S STATIC WATER LEVEL 68 ft. below land surface measured on mo/day/yr 8 / 17 / 90  
 Pump test data: Well water was ft. after hours pumping gpm  
 Est. Yield 15-20 gpm: Well water was ft. after hours pumping gpm  
 Bore Hole Diameter 9 in. to 96 ft., and in. to ft.  
 WELL WATER TO BE USED AS: 5 Public water supply 8 Air conditioning 11 Injection well  
 1 Domestic 3 Feedlot 6 Oil field water supply 9 Dewatering 12 Other (Specify below)  
 2 Irrigation 4 Industrial 7 Lawn and garden only 10 Monitoring well  
 Was a chemical/bacteriological sample submitted to Department? Yes No \* If yes, mo/day/yr sample was submitted  
 Water Well Disinfected? Yes \* No

5 TYPE OF BLANK CASING USED:  
 1 Steel 3 RMP (SR) 5 Wrought iron 8 Concrete tile CASING JOINTS: Glued \* Clamped  
 2 PVC 4 ABS 6 Asbestos-Cement 9 Other (specify below) Welded  
 7 Fiberglass Threaded  
 Blank casing diameter 5 in. to 96 ft. Dia. in. to ft. Dia. in. to ft.  
 Casing height above land surface 14 in. weight 200 lbs./ft. Wall thickness or gauge No.  
 TYPE OF SCREEN OR PERFORATION MATERIAL:  
 1 Steel 3 Stainless steel 5 Fiberglass 7 PVC 8 RMP (SR) 10 Asbestos-cement 11 Other (specify)  
 2 Brass 4 Galvanized steel 6 Concrete tile 9 ABS 12 None used (open hole)  
 SCREEN OR PERFORATION OPENINGS ARE:  
 1 Continuous slot 3 Mill slot 5 Gauzed wrapped 8 Saw cut 11 None (open hole)  
 2 Louvered shutter 4 Key punched 6 Wire wrapped 9 Drilled holes  
 7 Torch cut 10 Other (specify)  
 SCREEN-PERFORATED INTERVALS: From 66 ft. to 96 ft. From ft. to ft.  
 From ft. to ft. From ft. to ft.  
 GRAVEL PACK INTERVALS: From 31 ft. to 96 ft. From ft. to ft.  
 From ft. to ft. From ft. to ft.

6 GROUT MATERIAL: 1 Neat cement 2 Cement grout 3 Bentonite 4 Other  
 Grout Intervals: From 6 ft. to 31 ft. From ft. to ft. From ft. to ft.  
 What is the nearest source of possible contamination:  
 1 Septic tank 4 Lateral lines 7 Pit privy 10 Livestock pens 14 Abandoned water well  
 2 Sewer lines 5 Cess pool 8 Sewage lagoon 11 Fuel storage 15 Oil well/Gas well  
 3 Watertight sewer lines 6 Seepage pit 9 Feedyard 12 Fertilizer storage 16 Other (specify below)  
 13 Insecticide storage  
 Direction from well? WEST How many feet? 400

FROM	TO	LITHOLOGIC LOG	FROM	TO	PLUGGING INTERVALS
0	1	DARK TOP SOIL			
1	12	BROWN SANDY CLAY			
12	17	LITE COLOR LIMESTONE			
17	19	LITE COLOR SHALE			
19	27	LIMESTONE LITE COLOR			
27	31	LITE COLOR SHALE			
31	41	LITE COLOR LIMESTONE			
41	46	DARK LIMESTONE			
46	54	DARK SHALE			
54	60	GRAY LIMESTONE			
60	67	GRAY SHALE			
67	80	DARK LIMESTONE & FLINT ROCK			
80	86	LITE COLOR LIMESTONE			
86	96	DARK HARD LIMESTONE			

7 CONTRACTOR'S OR LANDOWNER'S CERTIFICATION: This water well was (1) constructed, (2) reconstructed, or (3) plugged under my jurisdiction and was completed on (mo/day/year) 8 / 17 / 90 and this record is true to the best of my knowledge and belief. Kansas Water Well Contractor's License No. 397 This Water Well Record was completed on (mo/day/yr) 11 / 2 / 90 under the business name of CENTRAL KANSAS DRILLING by (signature) Harold D. Martin

INSTRUCTIONS: Use typewriter or ball point pen. PLEASE PRESS FIRMLY and PRINT clearly. Please fill in blanks, underline or circle the correct answers. Send top three copies to Kansas Department of Health and Environment, Bureau of Water, Topeka, Kansas 66620-7320. Telephone: 913-296-5545. Send one to WATER WELL OWNER and retain one for your records.

0010971006-22

OFFICE USE ONLY