


1 LOCATION OF WATER WELL: Fraction NW 1/4 NE 1/4 NE 1/4 Section Number 29 Township Number T 12 S Range Number R 4 E/W  
 County: Dickinson  
 Distance and direction from nearest town or city street address of well if located within city? From Chapman 20 1/2 mile east on old 40 to Sage Rd + Go 1/3 mile north 1/4 mile west + 1/4 north

2 WATER WELL OWNER: Sean Fink  
 RR#, St. Address, Box #: 2617 Quail Rd. Board of Agriculture, Division of Water Resources  
 City, State, ZIP Code: Chapman, KS, 67431 Application Number:

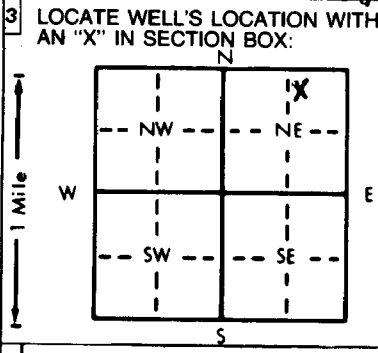

4 DEPTH OF COMPLETED WELL: 112 ft. ELEVATION:  
 Depth(s) Groundwater Encountered 1. 53 ft. 2. ft. 3. ft.  
 WELL'S STATIC WATER LEVEL 53 ft. below land surface measured on mo/day/yr  
 Pump test data: Well water was ft. after hours pumping gpm  
 Est. Yield 9 gpm: Well water was ft. after hours pumping gpm  
 Bore Hole Diameter . . . in. to 1 1/2 ft., and . . . in. to . . . ft.  
 WELL WATER TO BE USED AS:  
 1 Domestic  3 Feedlot  6 Oil field water supply  9 Dewatering  12 Other (Specify below)  
 2 Irrigation  4 Industrial  7 Lawn and garden only  10 Monitoring well  
 Was a chemical/bacteriological sample submitted to Department? Yes . . . . . No . . . . .; If yes, mo/day/yr sample was submitted

5 TYPE OF BLANK CASING USED:  
 1 Steel  3 RMP (SR)  5 Wrought iron  8 Concrete tile CASING JOINTS:  Glued . . . . . Clamped . . . . .  
 2 PVC  4 ABS  6 Asbestos-Cement  9 Other (specify below) Welded . . . . .  
 7 Fiberglass Threaded . . . . .  
 Blank casing diameter . . . . . in. to 92 ft. Dia . . . . . in. to . . . . . ft. Dia . . . . . in. to . . . . . ft.  
 Casing height above land surface . . . . . in., weight Sch 40 lbs./ft. Wall thickness or gauge No. . . . .  
 TYPE OF SCREEN OR PERFORATION MATERIAL:  
 1 Steel  3 Stainless steel  5 Fiberglass  7 PVC  10 Asbestos-cement  
 2 Brass  4 Galvanized steel  6 Concrete tile  8 RMP (SR)  11 Other (specify) . . . . .  
 9 ABS  12 None used (open hole)  
 SCREEN OR PERFORATION OPENINGS ARE:  
 1 Continuous slot  3 Mill slot 35/2000  5 Gauzed wrapped  8 Saw cut  11 None (open hole)  
 2 Louvered shutter  4 Key punched  6 Wire wrapped  9 Drilled holes  
 7 Torch cut  10 Other (specify) . . . . .  
 SCREEN-PERFORATED INTERVALS: From . . . . . ft. to 112 ft., From . . . . . ft. to . . . . . ft.  
 From . . . . . ft. to . . . . . ft., From . . . . . ft. to . . . . . ft.  
 GRAVEL PACK INTERVALS: From . . . . . 25 ft. to 112 ft., From . . . . . ft. to . . . . . ft.  
 From . . . . . ft. to . . . . . ft., From . . . . . ft. to . . . . . ft.

6 GROUT MATERIAL:  1 Neat cement  2 Cement grout  3 Bentonite  4 Other . . . . .  
 Grout Intervals: From . . . . . 0 ft. to 25 ft., From . . . . . ft. to . . . . . ft., From . . . . . ft. to . . . . . ft.  
 What is the nearest source of possible contamination:  
 1 Septic tank  4 Lateral lines  7 Pit privy  10 Livestock pens  14 Abandoned water well  
 2 Sewer lines  5 Cess pool  8 Sewage lagoon  11 Fuel storage  15 Oil well/Gas well  
 3 Watertight sewer lines  6 Seepage pit  9 Feedyard  12 Fertilizer storage  16 Other (specify below)  
 Direction from well? None close How many feet?

FROM	TO	LITHOLOGIC LOG	FROM	TO	PLUGGING INTERVALS
0	1	Top Soil			
1	22	Brown Clay			
22	30	Yellow Shale			
30	36	Limestone			
36	53	Yellow Shale			
53	94	Limestone			
94	112	Gray Shale			

7 CONTRACTOR'S OR LANDOWNER'S CERTIFICATION: This water well was  (1) constructed (2) reconstructed, or (3) plugged under my jurisdiction and was completed on (mo/day/year) 7/22/99 and this record is true to the best of my knowledge and belief. Kansas Water Well Contractor's License No. 451 This Water Well Record was completed on (mo/day/yr) 11/16/99 under the business name of Addeman Well Drilling by (signature) Wayne E. Cupp

OFFICE USE ONLY  
T  
R  
EM  
SEC.