


1 LOCATION OF WATER WELL: County: Dickinson Fraction SE 1/4 NW 1/4 NW 1/4 Section Number 32 Township Number T 12 S Range Number R 4 E/W

Distance and direction from nearest town or city street address of well if located within city? 302 E. Fourth St., Chapman

2 WATER WELL OWNER: Home Oil Company RR#, St. Address, Box #: Rt. 1, Box 4 City, State, ZIP Code: Chapman, Kansas 67431 Board of Agriculture, Division of Water Resources Application Number:

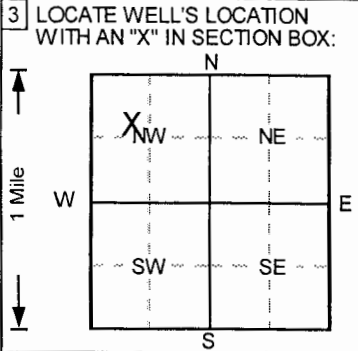

3 LOCATE WELL'S LOCATION WITH AN 'X' IN SECTION BOX: 4 DEPTH OF COMPLETED WELL: 25 ft. ELEVATION: 0. WELL'S STATIC WATER LEVEL: ... Pump test data: Well water was NA ft. after ... hours pumping ... gpm. Est. Yield: NA gpm. Well water was ... ft. after ... hours pumping ... gpm. Bore Hole Diameter: 11 in. to 25 ft., and ... in. to ... ft. WELL WATER TO BE USED AS: 5 Public water supply 8 Air conditioning 11 Injection well 1 Domestic 3 Feedlot 6 Oil field water supply 9 Dewatering 12 Other (Specify below) Soil vapor extract. 2 Irrigation 4 Industrial 7 Lawn and garden only 10 Monitoring well. Was a chemical/bacteriological sample submitted to Department? Yes.....No [checked]; If yes, mo/day/yr sample was submitted. Water Well Disinfected? Yes No [checked]

5 TYPE OF BLANK CASING USED: 1 Steel 3 RMP (SR) 5 Wrought iron 8 Concrete tile CASING JOINTS: Glued Clamped 2 PVC 4 ABS 6 Asbestos-Cement 9 Other (specify below) Welded 7 Fiberglass Threaded [checked] Blank casing diameter: 4 in. to 10 ft., Dia in. to ... ft., Dia in. to ... ft. Casing height above land surface: 0 in., weight ... lbs./ft. Wall thickness or gauge No. Sch. 40 TYPE OF SCREEN OR PERFORATION MATERIAL: 1 Steel 3 Stainless steel 5 Fiberglass 7 PVC 10 Asbestos-cement 2 Brass 4 Galvanized steel 6 Concrete tile 8 RMP (SR) 11 Other (specify) 12 None used (open hole) SCREEN OR PERFORATION OPENINGS ARE: 1 Continuous slot 3 Mill slot 5 Gauzed wrapped 8 Saw cut 11 None (open hole) 2 Louvered shutter 4 Key punched 6 Wire wrapped 9 Drilled holes 10 Other (specify) SCREEN-PERFORATED INTERVALS: From 10 ft. to 25 ft., From ... ft. to ... ft. GRAVEL PACK INTERVALS: From 8 ft. to 25 ft., From ... ft. to ... ft.

6 GROUT MATERIAL: 1 Neat cement 2 Cement grout 3 Bentonite 4 Other Grout intervals: From 0 ft. to 2 ft., From 2 ft. to 8 ft., From ... ft. to ... ft. What is the nearest source of possible contamination: 1 Septic tank 4 Lateral lines 7 Pit privy 10 Livestock pens 14 Abandoned water well 2 Sewer lines 5 Cess pool 8 Sewage lagoon 11 Fuel storage 15 Oil well/Gas well 3 Watertight sewer lines 6 Seepage pit 9 Feedyard 12 Fertilizer storage 16 Other (specify below) 13 Insecticide storage Direction from well? How many feet? 0

Table with columns: FROM, TO, LITHOLOGIC LOG, FROM, TO, PLUGGING INTERVALS. Rows include: 0-1 Fill Gravel and Clay, 1-5 Fill Clay, silty, sandy, Brown, 5-19 Fill Sand (f-m), Brown, 19-25 Clay, silty, sandy, tight, strong old gas odor, D. Includes SVEIR, Tag # 00366410, Flushmount, Project Name: GF - Home Oil Co., GeoCore # 1218, KDHE # US 021 00782

7 CONTRACTOR'S OR LANDOWNER'S CERTIFICATION: This water well was (1) constructed, (2) reconstructed, or (3) plugged under my jurisdiction and was completed on (mo/day/year) 9/8/2005 and this record is true to the best of my knowledge and belief. Kansas Water Well Contractor's License No. 527. This Water Well Record was completed on (mo/day/yr) 9/27/2005 under the business name of GeoCore, Inc. by (signature) Dale Kohl