


MW-2

1	LOCATION OF WATER WELL:	Fraction	Section Number	Township Number	Range Number
	County: Dickinson	SE 1/4 NW 1/4 NW 1/4	32	12	4 EW

Distance and direction from nearest town or city street address of well if located within city?
302 E. 4th St Chapman, KS

2 WATER WELL OWNER: Home Oil Company
RR #, St. Address, Box #: Rt. 1, Box 4
City, State, ZIP Code: Chapman KS 67431
Board of Agriculture, Division of Water Resources
Application Number:

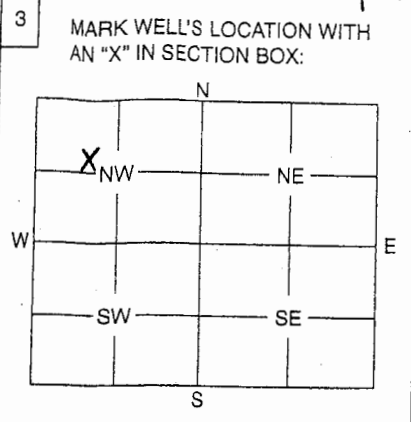

4 DEPTH OF WELL 30 ft.
WELL'S STATIC WATER LEVEL 26 ft.
WELL WAS USED AS:
 1 Domestic 5 Public Water Supply 9 Dewatering
 2 Irrigation 6 Oil Field Water Supply 10 Monitoring Well
 3 Feedlot 7 Domestic (Lawn & Garden) 11 Injection Well
 4 Industrial 8 Air Conditioning 12 Other

Was a chemical / bacteriological sample submitted to Department? Yes No... X.....
If yes, mo/day/yr sample was submitted

Water Well Disinfected: Yes No... X.....

5 TYPE OF BLANK CASING USED:
 1 Steel 3 RMP (SR) 5 Wrought 7 Fiberglass 9 Other (Specify below)
 2 PVC 4 ABS 6 Asbestos-Cement 8 Concrete Tile

Blank casing diameter 2 in. Was casing pulled? Yes X..... No If yes, how much 3'

6 GROUT PLUG MATERIAL: 1 Neat cement 2 Cement grout 3 Bentonite 4 Other

Grout Plug Intervals: From 3 ft. to 30 ft., From ft. to ft., From to ft.

What is the nearest source of possible contamination:
 1 Septic tank 6 Seepage pit 11 Fuel storage 16 Other (specify below)
 2 Sewer lines 7 Pit privy 12 Fertilizer storage

FROM	TO	PLUGGING MATERIALS
0'	3'	Native material
3'	30'	Bentonite chips

7 CONTRACTOR'S OF LANDOWNER'S CERTIFICATION: This water well was plugged under my jurisdiction and was completed on (mo/day/year) 3-29-10 and this record is true to the best of my knowledge and belief. Kansas Water Well Contractor's License No. This Water Well Record was completed on (mo/day/year) 4-28-10 under the business name of GreenField Contractors by (signature) Jean P. Pearson