

SUE-2

1	LOCATION OF WATER WELL:	Fraction	Section Number	Township Number	Range Number
	County: Dickinson	SE 1/4 NW 1/4 NW 1/4	32	12	4 EW

Distance and direction from nearest town or city street address of well if located within city?


302 E. 4th St Chapman, KS

2 WATER WELL OWNER: Home Oil Company

RR #, St. Address, Box #: Rt. 1, Box 4
City, State, ZIP Code : Chapman KS 67431

Board of Agriculture, Division of Water Resources
Application Number:

3 MARK WELL'S LOCATION WITH AN "X" IN SECTION BOX:

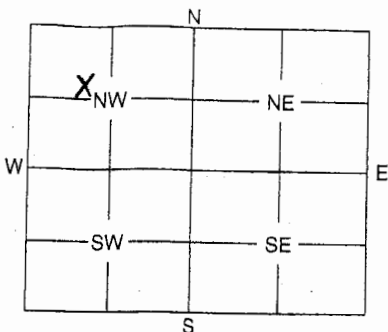

4 DEPTH OF WELL 25 ft.

WELL'S STATIC WATER LEVEL N/A ft.

WELL WAS USED AS:

- | | | |
|--------------|----------------------------|--------------------|
| 1 Domestic | 5 Public Water Supply | 9 Dewatering |
| 2 Irrigation | 6 Oil Field Water Supply | 10 Monitoring Well |
| 3 Feedlot | 7 Domestic (Lawn & Garden) | 11 Injection Well |
| 4 Industrial | 8 Air Conditioning | 12 Other SUE |

Was a chemical / bacteriological sample submitted to Department? Yes No X.....
If yes, mo/day/yr sample was submitted

Water Well Disinfected: Yes No X.....

5 TYPE OF BLANK CASING USED:

- | | | | | |
|---------|------------|-------------------|-----------------|-------------------------|
| 1 Steel | 3 RMP (SR) | 5 Wrought | 7 Fiberglass | 9 Other (Specify below) |
| 2 PVC | 4 ABS | 6 Asbestos-Cement | 8 Concrete Tile | |

Blank casing diameter 4 in. Was casing pulled? Yes X..... No If yes, how much 3'
Casing height above or below land surface in.

6 GROUT PLUG MATERIAL: 1 Neat cement 2 Cement grout 3 Bentonite 4 Other

Grout Plug Intervals: From 3 ft. to 25 ft., From ft. to ft., From to ft.

What is the nearest source of possible contamination:

- | | | | |
|--------------------------|-------------------|-------------------------|--------------------------|
| 1 Septic tank | 6 Seepage pit | 11 Fuel storage | 16 Other (specify below) |
| 2 Sewer lines | 7 Pit privy | 12 Fertilizer storage | |
| 3 Watertight sewer lines | 8 Sewage lagoon | 13 Insecticide storage | |
| 4 Lateral lines | 9 Feedyard | 14 Abandoned water well | |
| 5 Cess pool | 10 Livestock pens | 15 Oil well/Gas well | |

Direction from well? How many feet?

FROM	TO	PLUGGING MATERIALS
0'	3'	Native material
3'	25'	Bentonite chips

7 CONTRACTOR'S OF LANDOWNER'S CERTIFICATION: This water well was plugged under my jurisdiction and was completed on (mo/day/year) 3-29-10 and this record is true to the best of my knowledge and belief. Kansas Water Well Contractor's License No. This Water Well Record was completed on (mo/day/year) 4-28-10 under the business name of Green Field Contractors by (signature) Joan Peasaram