


1 LOCATION OF WATER WELL: County: Dickinson Fraction: SE 1/4 SE 1/4 NW 1/4 Section Number: 30 Township Number: T 12 @ Range Number: R 4 @ EW

Distance and direction from nearest town or city street address of well if located within city? From Chapman Go West 1 mile on 40 Hwy to Quail Rd. + Go North 2 miles to 2650 + 1/2 mile East

2 WATER WELL OWNER: Leon Thede  
 RR#, St. Address, Box #: 1937 2650 Ave.  
 City, State, ZIP Code: Chapman, KS 67431  
 Board of Agriculture, Division of Water Resources  
 Application Number:

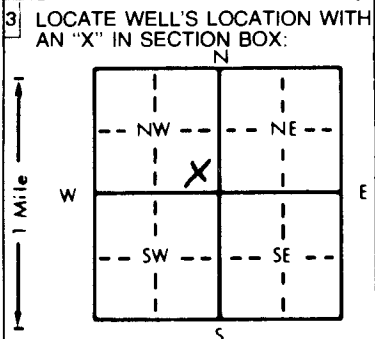

4 DEPTH OF COMPLETED WELL: 160 ft. ELEVATION:  
 Depth(s) Groundwater Encountered 1. 119 ft. 2. ft. 3. ft.  
 WELL'S STATIC WATER LEVEL: 119 ft. below land surface measured on mo/day/yr  
 Pump test data: Well water was ft. after hours pumping gpm  
 Est. Yield: 15 gpm: Well water was ft. after hours pumping gpm  
 Bore Hole Diameter: 9 in. to 160 ft., and in. to ft.  
 WELL WATER TO BE USED AS:  
 1 Domestic  3 Feedlot  6 Oil field water supply  9 Dewatering  12 Other (Specify below)  
 2 Irrigation  4 Industrial  7 Lawn and garden only  10 Monitoring well  
 Was a chemical/bacteriological sample submitted to Department? Yes No If yes, mo/day/yr sample was submitted  
 Water Well Disinfected:  Yes  No

5 TYPE OF BLANK CASING USED:  
 1 Steel  3 RMP (SR)  6 Asbestos-Cement  9 Other (specify below)  
 2 PVC  4 ABS  7 Fiberglass  
 Blank casing diameter: 5" in. to 140 ft. Dia. in. to ft. Dia. in. to ft.  
 Casing height above land surface: 2 in. weight 5 lb 40 lbs./ft. Wall thickness or gauge No.  
 TYPE OF SCREEN OR PERFORATION MATERIAL:  
 1 Steel  3 Stainless steel  5 Fiberglass  8 RMP (SR)  11 Other (specify)  
 2 Brass  4 Galvanized steel  6 Concrete tile  9 ABS  12 None used (open hole)  
 SCREEN OR PERFORATION OPENINGS ARE:  
 1 Continuous slot  3 Mill slot 25/1000  5 Gauzed wrapped  8 Saw cut  11 None (open hole)  
 2 Louvered shutter  4 Key punched  6 Wire wrapped  7 Torch cut  9 Drilled holes  10 Other (specify)  
 SCREEN-PERFORATED INTERVALS: From 140 ft. to 160 ft. From ft. to ft. From ft. to ft. From ft. to ft.  
 GRAVEL PACK INTERVALS: From 25 ft. to 160 ft. From ft. to ft. From ft. to ft. From ft. to ft.

6 GROUT MATERIAL:  1 Neat cement  2 Cement grout  3 Bentonite  4 Other  
 Grout Intervals: From 0 ft. to 25 ft. From ft. to ft. From ft. to ft. From ft. to ft.  
 What is the nearest source of possible contamination: None Close  
 1 Septic tank  4 Lateral lines  7 Pit privy  10 Livestock pens  14 Abandoned water well  
 2 Sewer lines  5 Cess pool  8 Sewage lagoon  11 Fuel storage  15 Oil well/Gas well  
 3 Watertight sewer lines  6 Seepage pit  9 Feedyard  12 Fertilizer storage  16 Other (specify below)  
 13 Insecticide storage  
 Direction from well? How many feet?

FROM	TO	LITHOLOGIC LOG	FROM	TO	PLUGGING INTERVALS
0	1	Top Soil			
1	19	Sandy Clay			
19	49	Brown Clay			
49	67	Limestone			
67	85	Yellow Shale			
85	109	Brown Shale			
109	112	Limestone			
112	119	Brown Shale			
119	133	Limestone (Water)			
133	144	Brown Shale			
144	160	Limestone			

7 CONTRACTOR'S OR LANDOWNER'S CERTIFICATION: This water well was  (1) constructed,  (2) reconstructed, or  (3) plugged under my jurisdiction and was completed on (mo/day/year) 2/19/98 and this record is true to the best of my knowledge and belief. Kansas Water Well Contractor's License No. 451 This Water Well Record was completed on (mo/day/yr) 2/25/98 under the business name of Holdeman Well Drilling by (signature) Craig B. Cuyler

OFFICE USE ONLY T R SEC 1/4 1/4 1/4