


1 LOCATION OF WATER WELL: Fraction SW 1/4 SW 1/4 NW 1/4 Section Number 22 Township Number T 12 S Range Number R 5 E/W
 Distance and direction from nearest town or city street address of well if located within city? From J.C. & 77418 Hwy 603
1 mile south to old 40 & 60 1/2 mile west

2 WATER WELL OWNER: J.C. Foundry Inc.
 RR#, St. Address, Box # 1905 Old Hwy 40 Board of Agriculture, Division of Water Resources
 City, State, ZIP Code: J.C. Kansas 66441 Application Number:

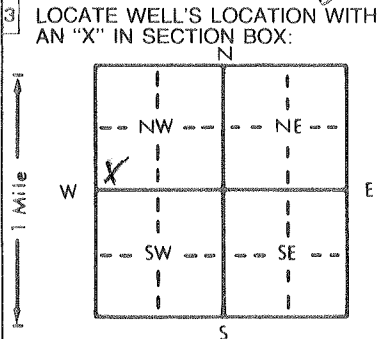

4 DEPTH OF COMPLETED WELL: 5'5" ft. ELEVATION:
 Depth(s) Groundwater Encountered 1. 21 ft. 2. ft. 3. ft.
 WELL'S STATIC WATER LEVEL 27 ft. below land surface measured on mo/day/yr
 Pump test data: Well water was ft. after hours pumping gpm
 Est. Yield 21 gpm: Well water was ft. after hours pumping gpm
 Bore Hole Diameter 10 in. to 5.5 in. to in. to in. to ft.
 WELL WATER TO BE USED AS:
 1 Domestic 3 Feedlot 6 Oil field water supply 9 Dewatering 12 Other (Specify below)
 2 Irrigation 4 Industrial 7 Lawn and garden only 10 Monitoring well
 Was a chemical/bacteriological sample submitted to Department? Yes.....No..... If yes, mo/day/yr sample was sub-
 mitted Water Well Disinfected? Yes No

5 TYPE OF BLANK CASING USED:
 1 Steel 3 RMP (SR) 6 Asbestos-Cement 9 Other (specify below) Welded
 2 PVC 4 ABS 7 Fiberglass Threaded
 Blank casing diameter 5 in. to 3.5 ft., Dia. in. to in. to ft., Dia. in. to in. to ft.
 Casing height above land surface 21 in., weight sch. 40 lbs./ft. Wall thickness or gauge No.
 TYPE OF SCREEN OR PERFORATION MATERIAL:
 1 Steel 3 Stainless steel 5 Fiberglass 7 PVC 10 Asbestos-cement
 2 Brass 4 Galvanized steel 6 Concrete tile 9 ABS 11 Other (specify)
 SCREEN OR PERFORATION OPENINGS ARE:
 1 Continuous slot 3 Mill slot 10/100's 5 Gauzed wrapped 8 Saw cut 11 None (open hole)
 2 Louvered shutter 4 Key punched 6 Wire wrapped 9 Drilled holes
 7 Torch cut 10 Other (specify)
 SCREEN-PERFORATED INTERVALS: From 3.5 ft. to 5.5 ft., From ft. to ft. to ft.
 From ft. to ft. to ft. to ft. to ft.
 GRAVEL PACK INTERVALS: From 20 ft. to 5.5 ft., From ft. to ft. to ft. to ft. to ft.
 From ft. to ft. to ft. to ft. to ft.

6 GROUT MATERIAL: 1 Neat cement 2 Cement grout 3 Bentonite 4 Other
 Grout Intervals: From 0 ft. to 20 ft., From ft. to ft. to ft., From ft. to ft. to ft.
 What is the nearest source of possible contamination:
 1 Septic tank 4 Lateral lines 7 Pit privy 10 Livestock pens 14 Abandoned water well
 2 Sewer lines 5 Cess pool 8 Sewage lagoon 11 Fuel storage 15 Oil well/Gas well
 3 Watertight sewer lines 6 Seepage pit 9 Feedyard 12 Fertilizer storage 16 Other (specify below)
 13 Insecticide storage
 Direction from well? 300' Southwest How many feet? 300'

| FROM | TO | LITHOLOGIC LOG | FROM | TO | PLUGGING INTERVALS |
|------|-----|--------------------|------|----|--------------------|
| 0 | 2 | Top Soil | | | |
| 2 | 21 | Brown Clay | | | |
| 21 | 3.5 | Sandy Clay (Water) | | | |
| 3.5 | 41 | Grey Shale | | | |
| 41 | 5.5 | Limestone | | | |

7 CONTRACTOR'S OR LANDOWNER'S CERTIFICATION: This water well was (1) constructed, (2) reconstructed, or (3) plugged under my jurisdiction and was completed on (mo/day/year) 11/15/196 and this record is true to the best of my knowledge and belief. Kansas Water Well Contractor's License No. 451 This Water Well Record was completed on (mo/day/yr) 12/18/96 under the business name of Holdemer Well Drilling by (signature) Craig H. Cupps