


WATER WELL RECORD Form WWC-5 KSA 82a-1212

LOCATION OF WATER WELL: County: Geary Fraction ~~NE~~ ~~NW~~ ~~NW~~ ~~NW~~ 1/4 1/4 1/4 Section Number ~~34~~ ~~34~~ Township Number T ~~12~~ ~~12~~ S Range Number R ~~7~~ ~~7~~ SE EW

Distance and direction from nearest town or city street address of well if located within city? 1 mile N, 3/4 mile West of Jct. Hwy 77-18 West of I-70 from Junction City to McDowell Creek Road, so South 5 miles, right side of road by Junction City

WATER WELL OWNER: Ken German RR#, St. Address, Box #: Alta Vista, City, State, ZIP Code: Kansas 66834 Board of Agriculture, Division of Water Resources Application Number:

LOCATE WELL'S LOCATION WITH AN "X" IN SECTION BOX: DEPTH OF COMPLETED WELL: 120' ft. ELEVATION: 80' ft.

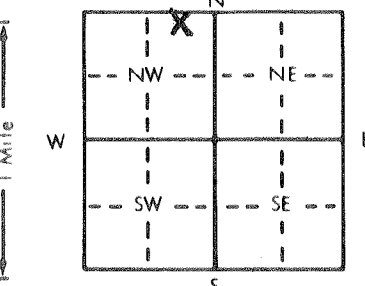

Depth(s) Groundwater Encountered 1. 80' ft. 2. ... ft. 3. ... ft. WELL'S STATIC WATER LEVEL 65' ft. below land surface measured on mo/day/yr 8-19-1982 Pump test data: Well water was 120' ft. after 3/4 hours pumping 1.5 gpm Est. Yield 1.5 gpm: Well water was ... ft. after ... hours pumping ... gpm Bore Hole Diameter 8" in. to 120' ft., and ... in. to ... ft. WELL WATER TO BE USED AS: 5 Public water supply 8 Air conditioning 11 Injection well X1 Domestic 3 Feedlot 6 Oil field water supply 9 Dewatering 12 Other (Specify below) 2 Irrigation 4 Industrial 7 Lawn and garden only 10 Observation well Was a chemical/bacteriological sample submitted to Department? Yes ... No X ...; If yes, mo/day/yr sample was submitted Water Well Disinfected? Yes X No

TYPE OF BLANK CASING USED: 1 Steel 3 RMP (SR) X2 PVC 4 ABS 5 Wrought iron 6 Asbestos-Cement 7 Fiberglass 8 Concrete tile 9 Other (specify below) CASING JOINTS: Glued X Clamped Welded Threaded Blank casing diameter 5" in. to 100' ft., Dia 3 in. to ... ft., Dia ... in. to ... ft. Casing height above land surface 1.2 in., weight ... lbs./ft. Wall thickness or gauge No. 258

TYPE OF SCREEN OR PERFORATION MATERIAL: 1 Steel 3 Stainless steel 5 Fiberglass X7 PVC 10 Asbestos-cement 2 Brass 4 Galvanized steel 6 Concrete tile 8 RMP (SR) 11 Other (specify) 12 None used (open hole) SCREEN OR PERFORATION OPENINGS ARE: 1 Continuous slot 3 Mill slot 5 Gauzed wrapped X8 Saw cut 11 None (open hole) 2 Louvered shutter 4 Key punched 6 Wire wrapped 9 Drilled holes 7 Torch cut 10 Other (specify)

SCREEN-PERFORATED INTERVALS: From 100 ft. to 120 ft., From ... ft. to ... ft. GRAVEL PACK INTERVALS: From 10 ft. to 120 ft., From ... ft. to ... ft.

GROUT MATERIAL: 1 Neat cement 0 X2 Cement grout 3 Bentonite 4 Other Grout Intervals: From 0 ft. to 10 ft., From ... ft. to ... ft. What is the nearest source of possible contamination: NONE 10 Livestock pens 14 Abandoned water well 1 Septic tank 4 Lateral lines 7 Pit privy 11 Fuel storage 15 Oil well/Gas well 2 Sewer lines 5 Cess pool 8 Sewage lagoon 12 Fertilizer storage 16 Other (specify below) 3 Watertight sewer lines 6 Seepage pit 9 Feedyard 13 Insecticide storage

Direction from well? How many feet?

FROM	TO	LITHOLOGIC LOG	FROM	TO	LITHOLOGIC LOG
0	3	Top Soil & Clay 01			
3	6	Rock 28			
6	22	Clay 01			
22	25	Rock 28			
25	62	Clay 01			
62	63	Rock 28			
63	80	Clay 01			
80	114	Shale 19			
114	117	Limerock 20			
117	120	Shale 19			

CONTRACTOR'S OR LANDOWNER'S CERTIFICATION: This water well was (1) constructed (2) reconstructed, or (3) plugged under my jurisdiction and was completed on (mo/day/year) August 19, 1982 and this record is true to the best of my knowledge and belief. Kansas Water Well Contractor's License No. 361 This Water Well Record was completed on (mo/day/yr) September 15, 1982 under the business name of Cox - Beswick Irrigation Service, Inc. by (signature) Francis Cox

INSTRUCTIONS: Use typewriter or ball point pen, PLEASE PRESS FIRMLY and PRINT clearly. Please fill in blanks, underline or circle the correct answers. Send top three copies to Kansas Department of Health and Environment, Division of Environment, Environmental Geology Section, Topeka, KS 66620. Send one to WATER WELL OWNER and retain one for your records.