


WATER WELL RECORD Form WWC-5 KSA 82a-1212

1 LOCATION OF WATER WELL: Fraction SE 1/4 SE 1/4 NE 1/4 Section Number 4 Township Number T 12 S Range Number R 5 EW
 County: GEARY

Distance and direction from nearest town or city street address of well if located within city? FROM JUNCTION CITY - 1 1/2 MILES WEST ON 18 HIGHWAY TO SPRING VALLEY ROAD THEN GO 1/2 MILE SOUTH

2 WATER WELL OWNER: BILL REIMLER
 RR#, St. Address, Box #: RR3 BOX 153
 City, State, ZIP Code: JUNCTION CITY, KANSAS 66641
 Board of Agriculture, Division of Water Resources
 Application Number:

3 LOCATE WELL'S LOCATION WITH AN "X" IN SECTION BOX:

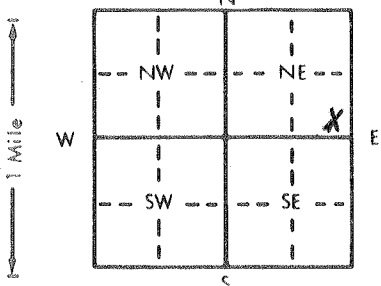

4 DEPTH OF COMPLETED WELL: 161 ft. ELEVATION: ft.
 Depth(s) Groundwater Encountered 1 69 ft. 2. ft. 3. ft.
 WELL'S STATIC WATER LEVEL 60 ft. below land surface measured on mo/day/yr ft.
 Pump test data: Well water was ft. after hours pumping gpm
 Est. Yield 8 gpm: Well water was ft. after hours pumping gpm
 Bore Hole Diameter: 8 in. to 161 ft., and in. to ft.
 WELL WATER TO BE USED AS:
 Domestic 3 Feedlot 6 Oil field water supply 9 Dewatering 12 Other (Specify below)
 2 Irrigation 4 Industrial 7 Lawn and garden only 10 Monitoring well
 Was a chemical/bacteriological sample submitted to Department? Yes No X If yes, mo/day/yr sample was submitted
 Water Well Disinfected? Yes X No SCREWED

5 TYPE OF BLANK CASING USED:
 1 Steel 3 RMP (SR) 5 Wrought iron 8 Concrete tile CASING JOINTS: Glued SCREWED Clamped
 2 PVC 4 ABS 6 Asbestos-Cement 9 Other (specify below) Welded
 7 Fiberglass Threaded

Blank casing diameter: 5 in. to 140 ft., Dia. in. to ft., Dia. in. to ft.
 Casing height above land surface: 2' in., weight SCH 40 lbs./ft. Wall thickness or gauge No.

TYPE OF SCREEN OR PERFORATION MATERIAL:
 1 Steel 3 Stainless steel 5 Fiberglass 8 RMP (SR) 10 Asbestos-cement
 2 Brass 4 Galvanized steel 6 Concrete tile 9 ABS 11 Other (specify)
 12 None used (open hole)

SCREEN OR PERFORATION OPENINGS ARE:
 1 Continuous slot 3 Mill slot 31/1000 5 Gauzed wrapped 8 Saw cut 11 None (open hole)
 2 Louvered shutter 4 Key punched 6 Wire wrapped 9 Drilled holes
 7 Torch cut 10 Other (specify)

SCREEN-PERFORATED INTERVALS: From 140 ft. to 160 ft., From ft. to ft.
 From ft. to ft., From ft. to ft.

GRAVEL PACK INTERVALS: From 20 ft. to 161 ft., From ft. to ft.
 From ft. to ft., From ft. to ft.

6 GROUT MATERIAL: 1 Neat cement 2 Cement grout 3 Bentonite 4 Other Emulsified
 Grout Intervals: From ft. to ft., From ft. to ft.

What is the nearest source of possible contamination:
 1 Septic tank 4 Lateral lines 7 Pit privy 10 Livestock pens 14 Abandoned water well
 2 Sewer lines 5 Cess pool 8 Sewage lagoon 11 Fuel storage 15 Oil well/Gas well
 3 Watertight sewer lines 6 Seepage pit 9 Feedyard 12 Fertilizer storage 16 Other (specify below)
 13 Insecticide storage

Direction from well? SE How many feet? 75

FROM	TO	LITHOLOGIC LOG	FROM	TO	PLUGGING INTERVALS
0	8	BROWN CLAY	158	160	ROCK
8	14	LIMESTONE	160	161	GREY SHALE
14	46	GREY SHALE			
46	69	LIME STONE			
69	77	GREY SHALE			
77	93	BROWN SHALE			
93	109	GREY SHALE			
109		LIME STONE			
	125	GREY SHALE			
125	126	LIME STONE			
126	130	BROWN SHALE			
130	133	LIME STONE			
133	134	BROWN SHALE			
134	139	LIME STONE			
139	158	GREY SHALE			

7 CONTRACTOR'S OR LANDOWNER'S CERTIFICATION: This water well was (1) constructed, (2) reconstructed, or (3) plugged under my jurisdiction and was completed on (mo/day/year) 10/2/89 and this record is true to the best of my knowledge and belief. Kansas Water Well Contractor's License No. 451 This Water Well Record was completed on (mo/day/yr) 11/4/89 under the business name of HALDEMAN WELL DRILLING by (signature) Craig